


T.2S. R.2W. W.M.

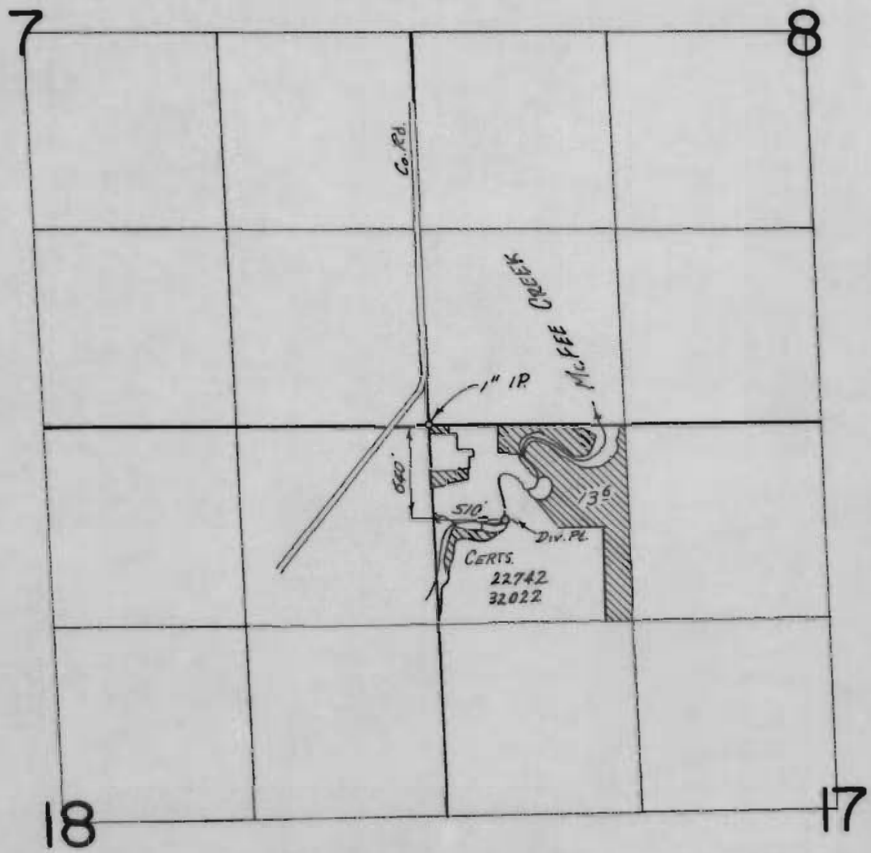

FINAL PROOF SURVEY
UNDER

Application No. 46775 Permit No. 34916....
IN NAME OF

DALE P. & PATRICIA A. GOSSELIN

Surveyed June 20 1974, by R. G. MUCKEN