


T.2N.R.4W.W.M.

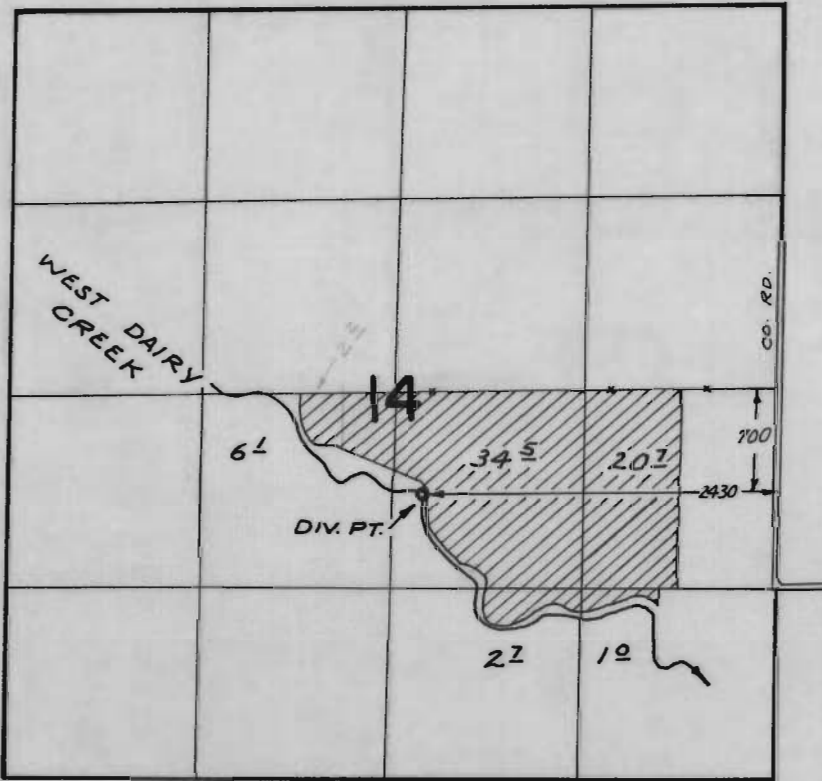

FINAL PROOF SURVEY
UNDER

Application No. 46826 Permit No. 35015
IN NAME OF

SCHMIDLIN BROS.

Surveyed APR. 4, 1974, by R. MUCKEN