


# T.1S. R.4W. W.M.

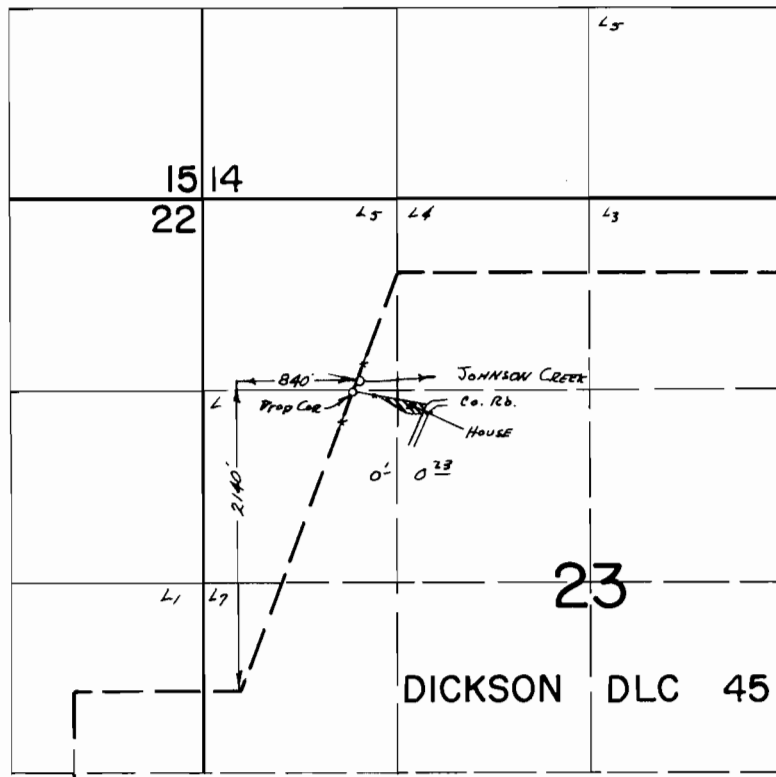

## FINAL PROOF SURVEY UNDER

Application No. 46850... Permit No. 35032...  
IN NAME OF

MRS. H. W. SUNDERMEIER

Surveyed Sep. 30 1974, by R. G. MUCKEN