T.1S. R.3W. W.M.

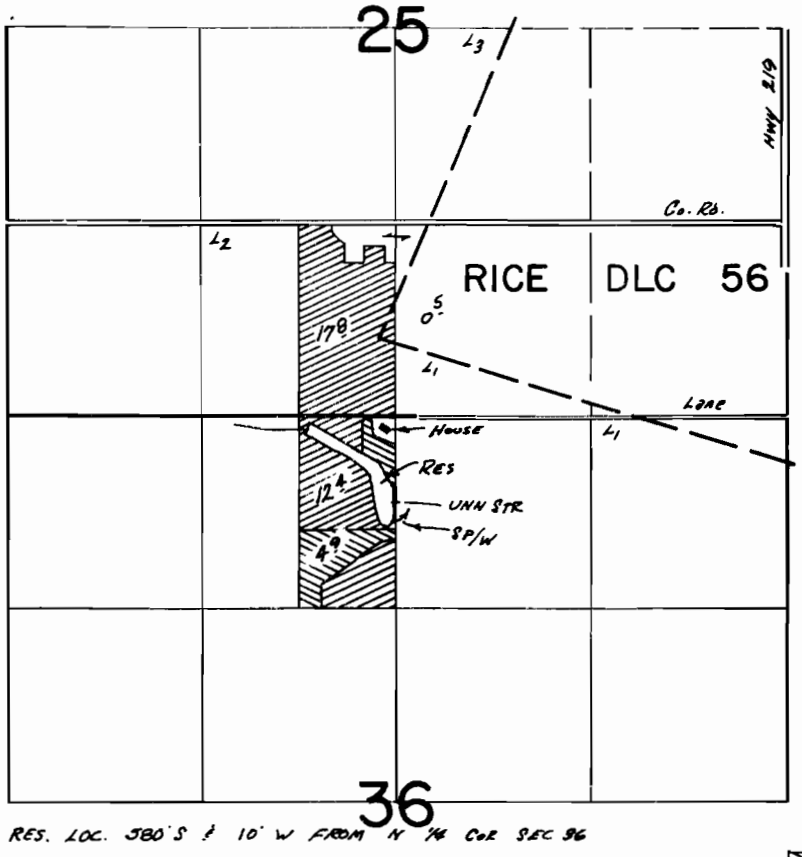

Primary

Supplemental

FINAL PROOF SURVEY
UNDER

R-47386 R-5705
Application No. 47387 Permit No. 35489
IN NAME OF

WILLIAM OLDENBURG

Surveyed Oct. 1 1974, by R. G. MUCKEN

DBS-ALL-26 TP