

MAP TO ACCOMPANY
WATER RIGHT APPLICATION OF
KENNETH C. KING
IN SW 1/4 SECTION 31, T3N, R3W, W.M.
Washington County, Oregon


Scale: 1" = 400'
8 May 1971

RECEIVED

MAY 27 1971

STATE ENGINEER
SALEM, OREGON

Application No. 48269
Permit No. 36254

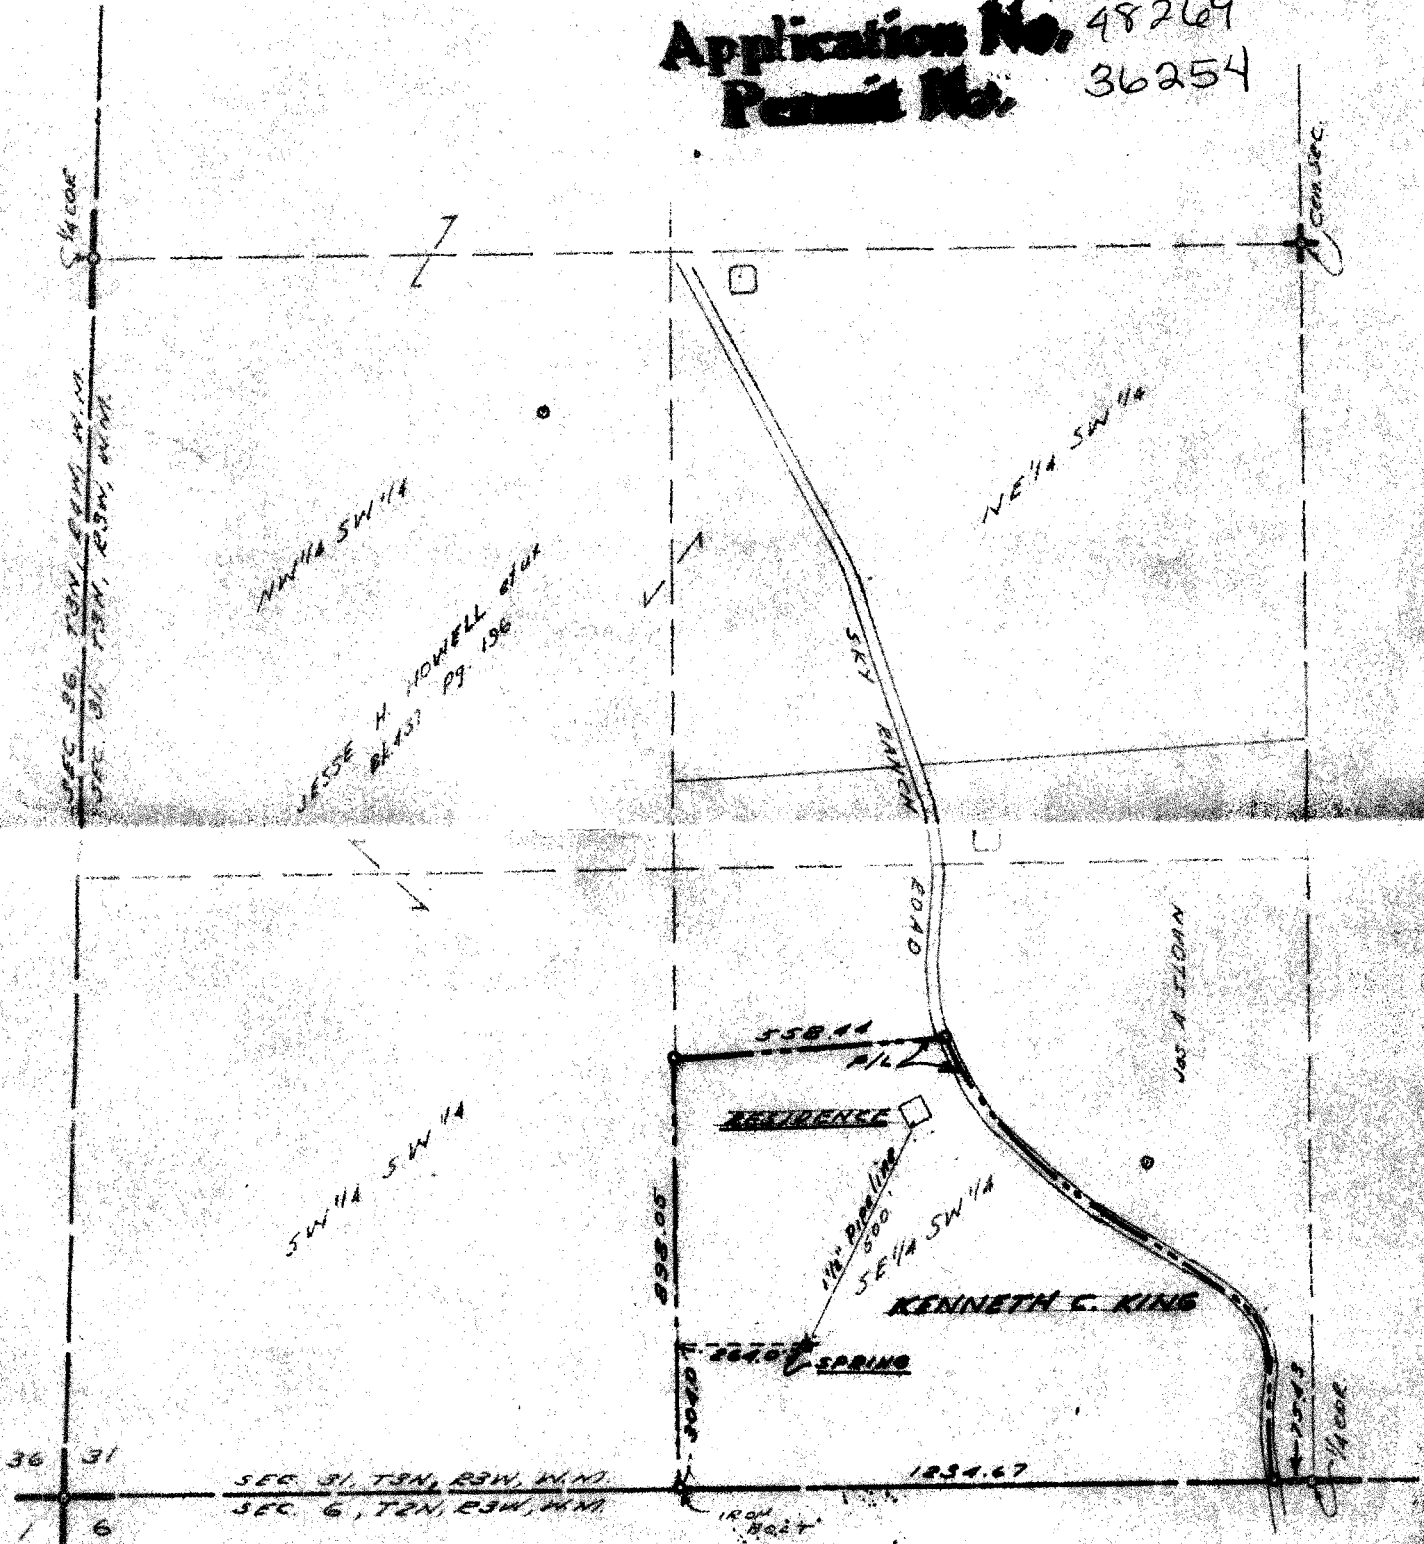

h. a. mohr & ASSOCIATES
CIVIL ENGINEERS



181571