


T.1S. R.3W. W.M.

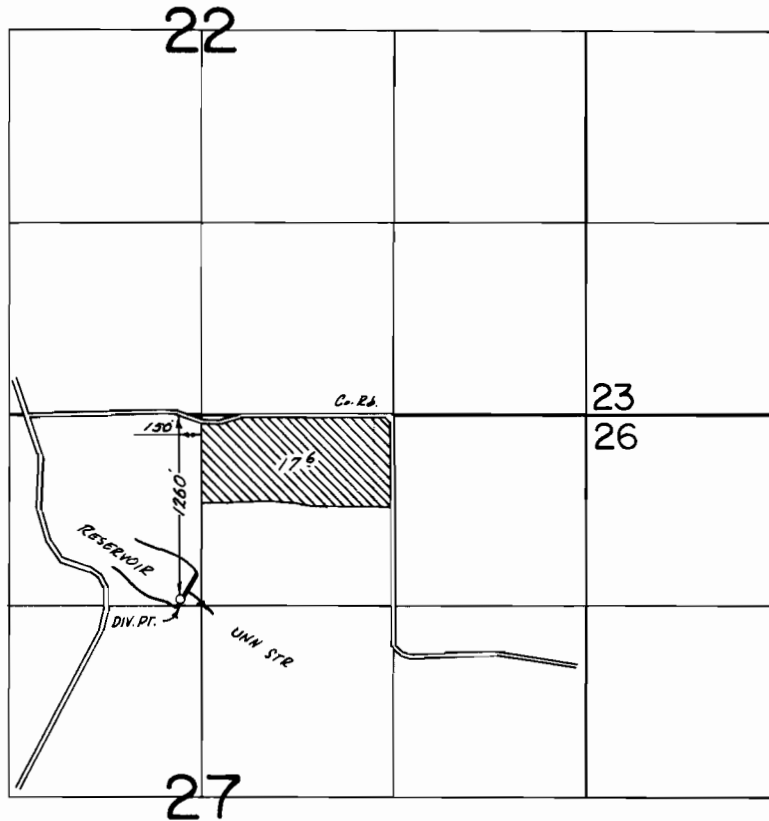

**FINAL PROOF SURVEY**  
UNDER

Application No. 49627... Permit No. 37225...  
IN NAME OF

.....  
GLEN SPANGLER  
.....

Surveyed July 25, 1974, by R. G. MUCKEN