


T.2S. R.2W. W. M.

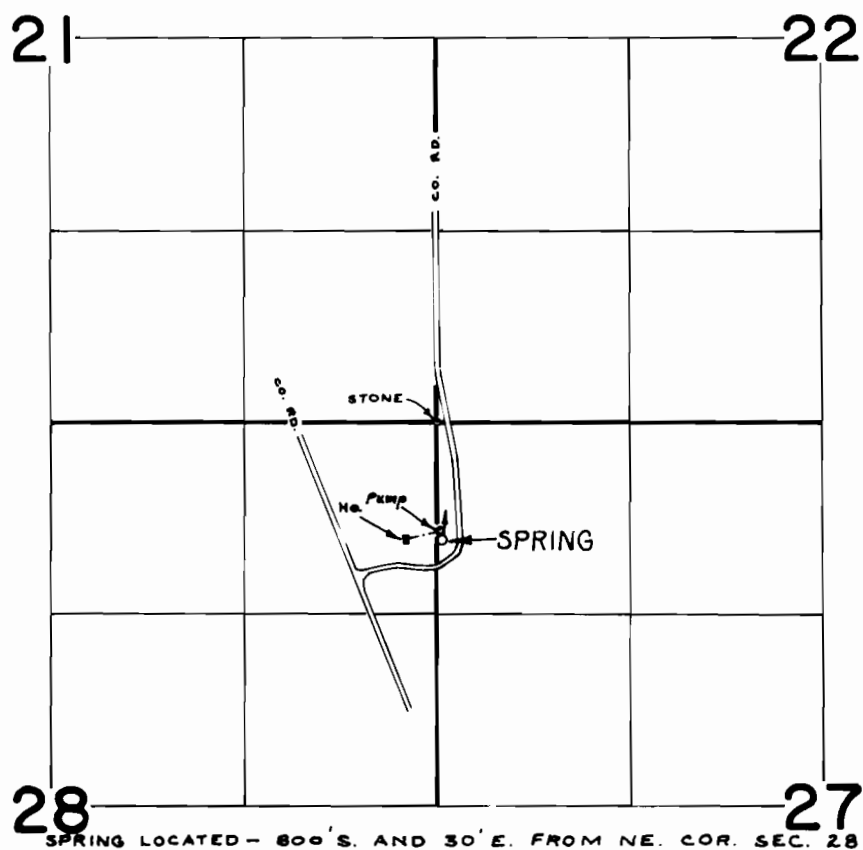

FINAL PROOF SURVEY
UNDER

Application No. 49758 Permit No. 37255
IN NAME OF

DENNIS R. MCFALL

Surveyed May 14, 1975, by R. Mucken