


T. 15 S. R. 5 W. W.M.

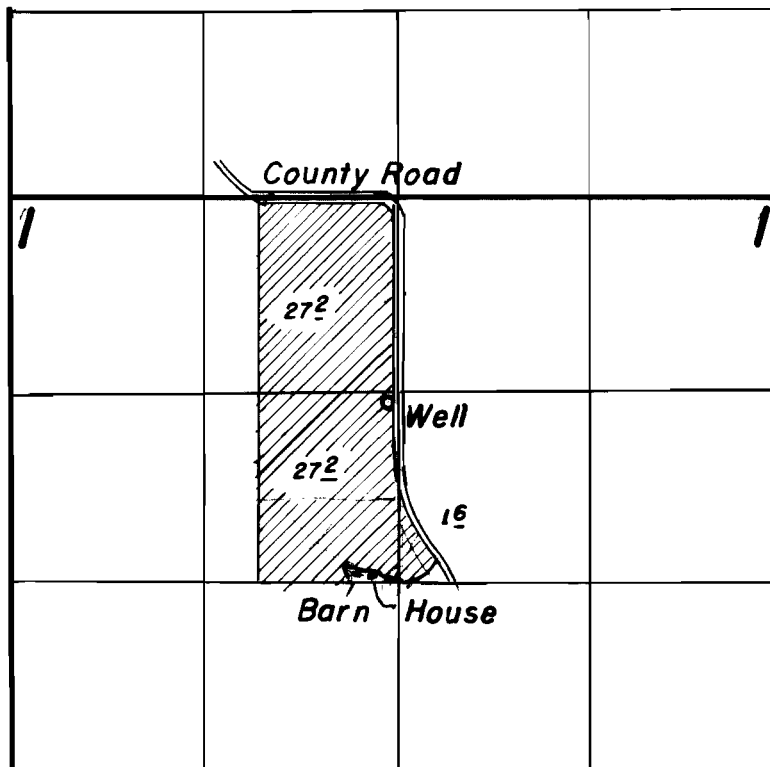

FINAL PROOF SURVEY
UNDER

Application No. G-1728 Permit No. G-1582
IN NAME OF

Harry O. Hansen

Surveyed June 13 1963, by Floyd L. Siegmund