


T.5S.R.1E.W.M.

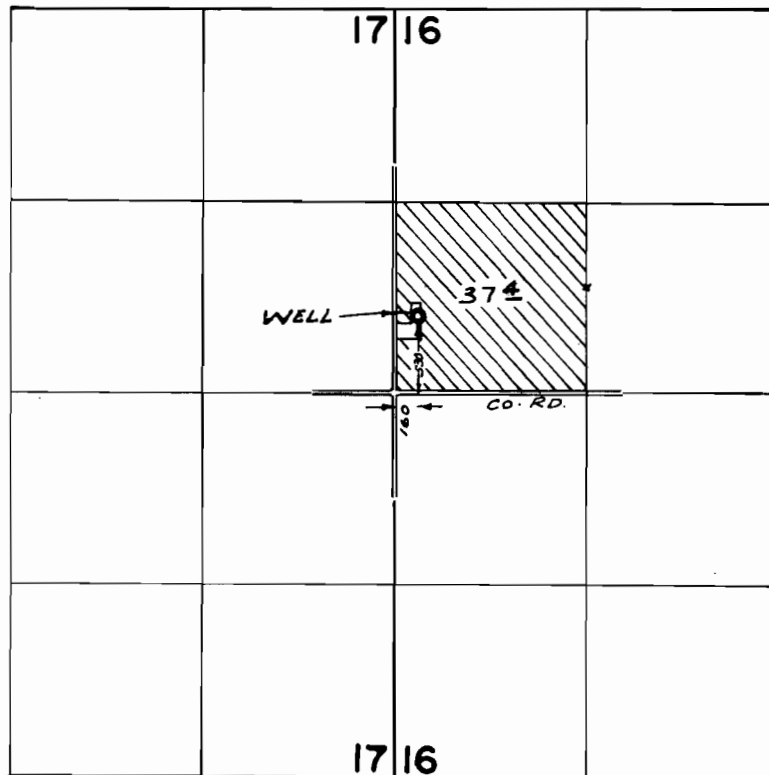

FINAL PROOF SURVEY
UNDER

Application No. G-3805 Permit No. G-3590
IN NAME OF

TOM WATTS

Surveyed APR. 29, 1971, by R. MUCKEN