


T.5S.R.1E.W.M.

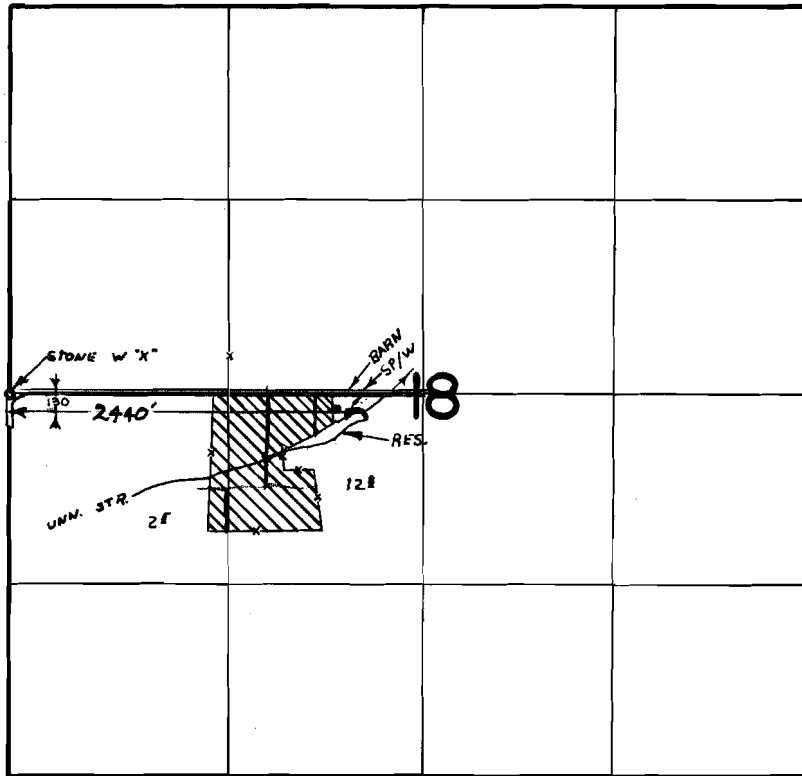

FINAL PROOF SURVEY UNDER

R-43681 R-5016
Application No. 43682 Permit No. 32650
IN NAME OF

ELMER H. SCHNEIDER

Surveyed APR. 29. 1971., by R. MUCKEN