


T. 27S. R. 6W. WM.

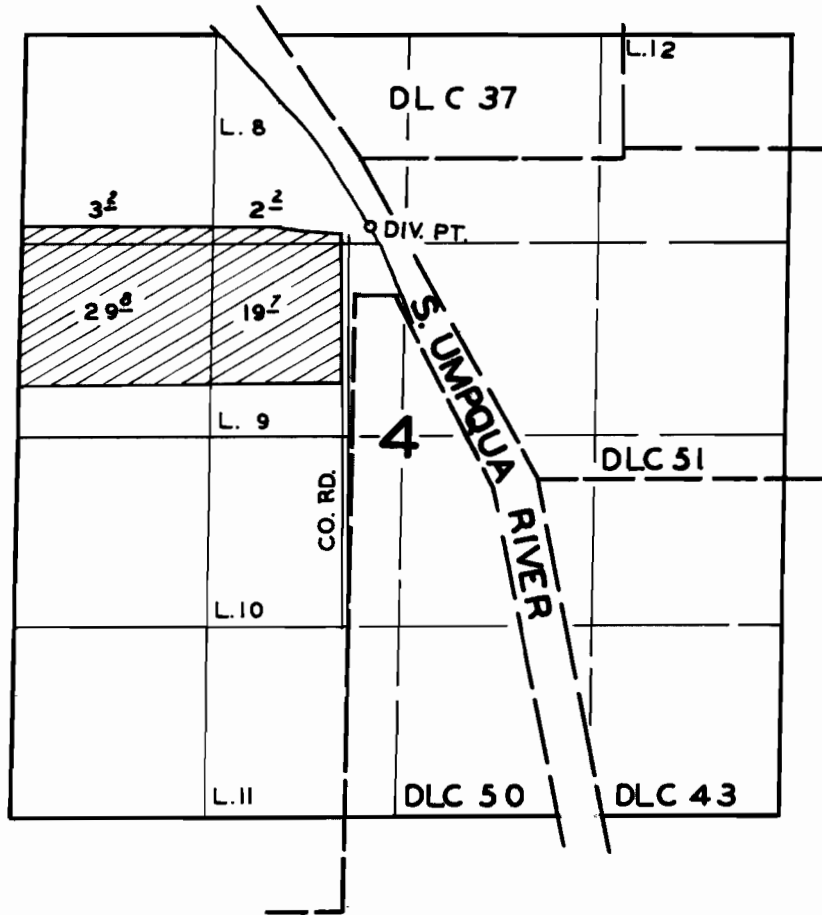

FINAL PROOF SURVEY
UNDER

Application No. 29833 Permit No. 23462
IN NAME OF

..... **BUSENBARK BROS.**

Surveyed SEPT. 2 1960., by G. O. BARTELS