


T.25S. R.6W. W.M.

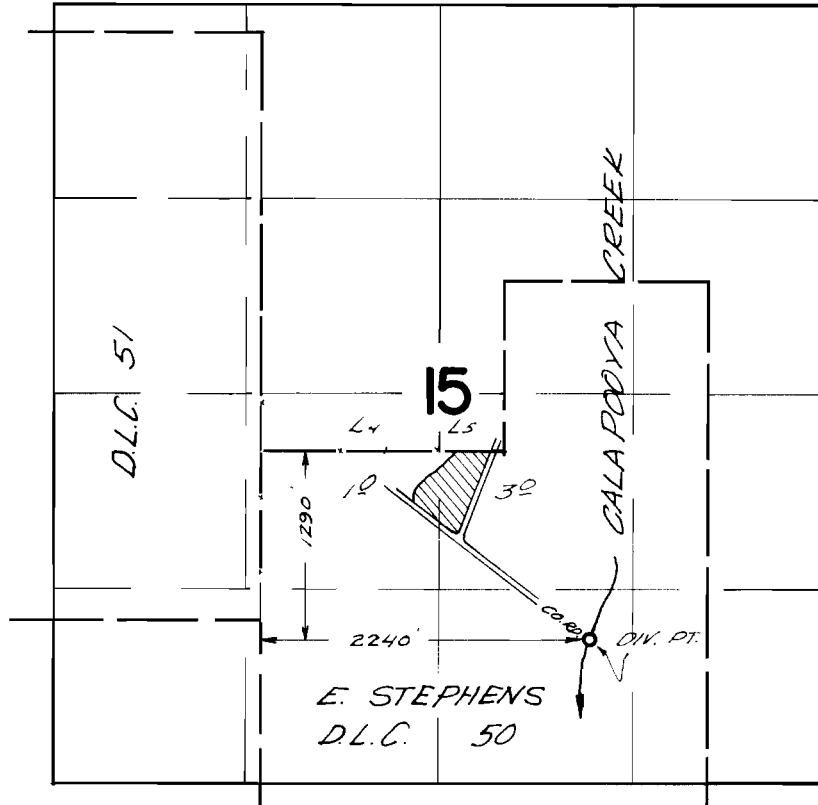

FINAL PROOF SURVEY UNDER

Application No. 37070 Permit No. 27579
IN NAME OF

MARY K. FORSTER

Surveyed *April 27 19.67*, by *V. Garner*