


T.38S.,R.5W.,W.M.

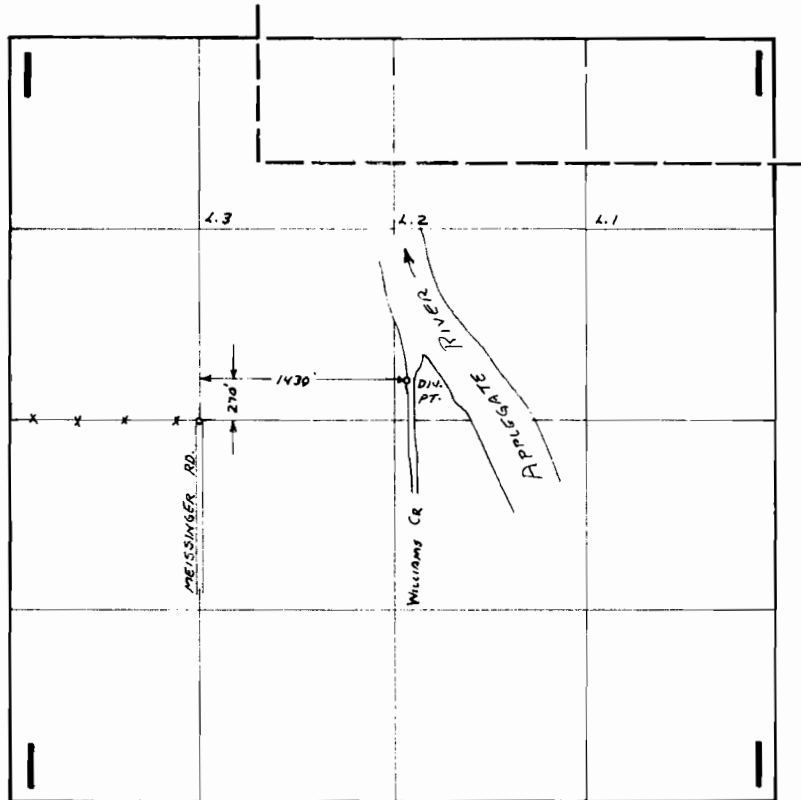

Transfer No. 2430

C. E. WILLSON

Oct. 4 74 L. Toll