


U-384

27228
43713 RR
Red area has been
Cancelled

T.39S.R.11E.W.M.

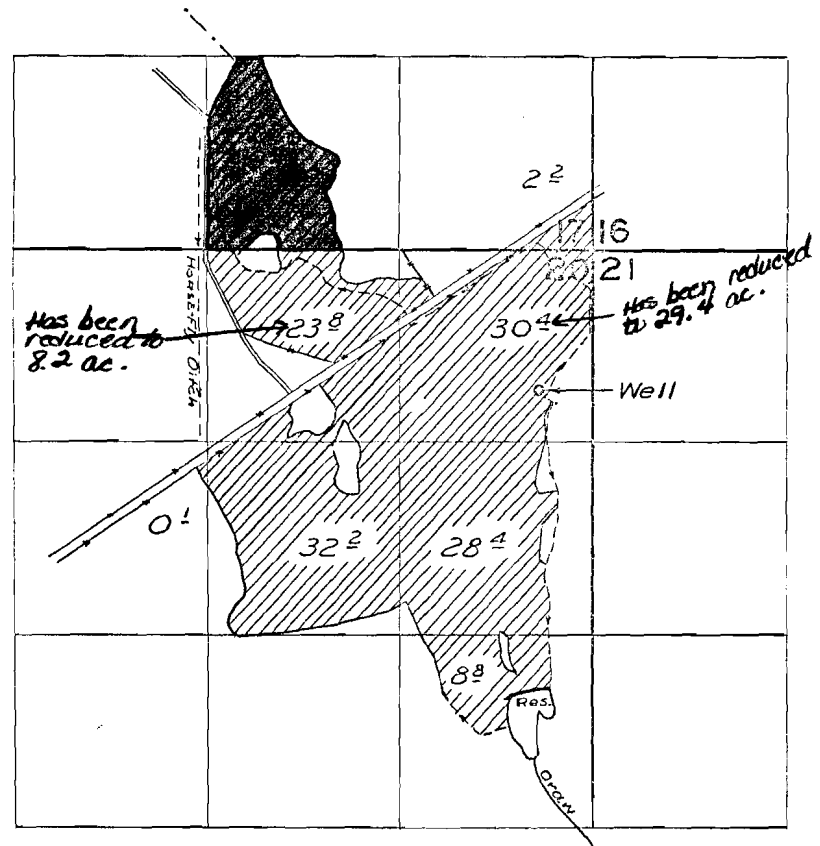

FIELD PROOF SURVEY

Applied for U-420 and U-384

HOMER M. HOLT

Surveyed 12 Oct. 1959 by Tr. Bush