

6-4904


41094

43774

T9461

T9420

T. 25 S. R. 17 E. WM.

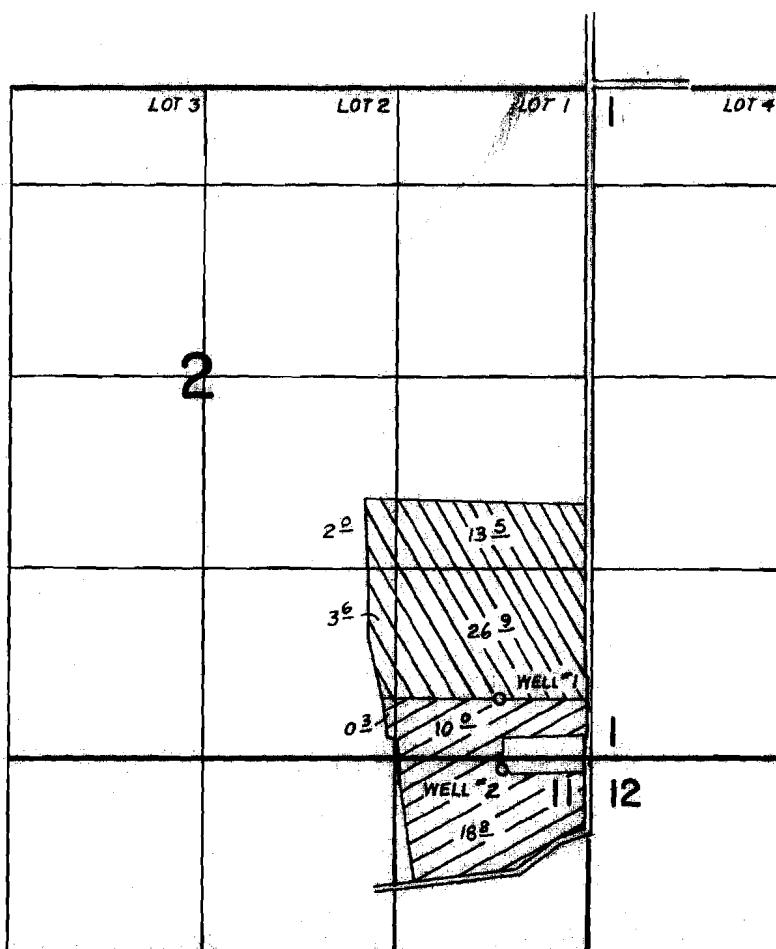

WELL #1 4210' S & 600' W FROM NE COR. SEC. 2



WELL #2 4700' S & 580' W FROM NE COR. SEC. 2


FINAL PROOF SURVEY
UNDER

Application No. G-5173 Permit No. G-4904
IN NAME OF

FELIX A. FRAZEE

Surveyed AUG 22, 1973, by R.G. MUCKEN

T. 25 S. R. 17 E. W.M.

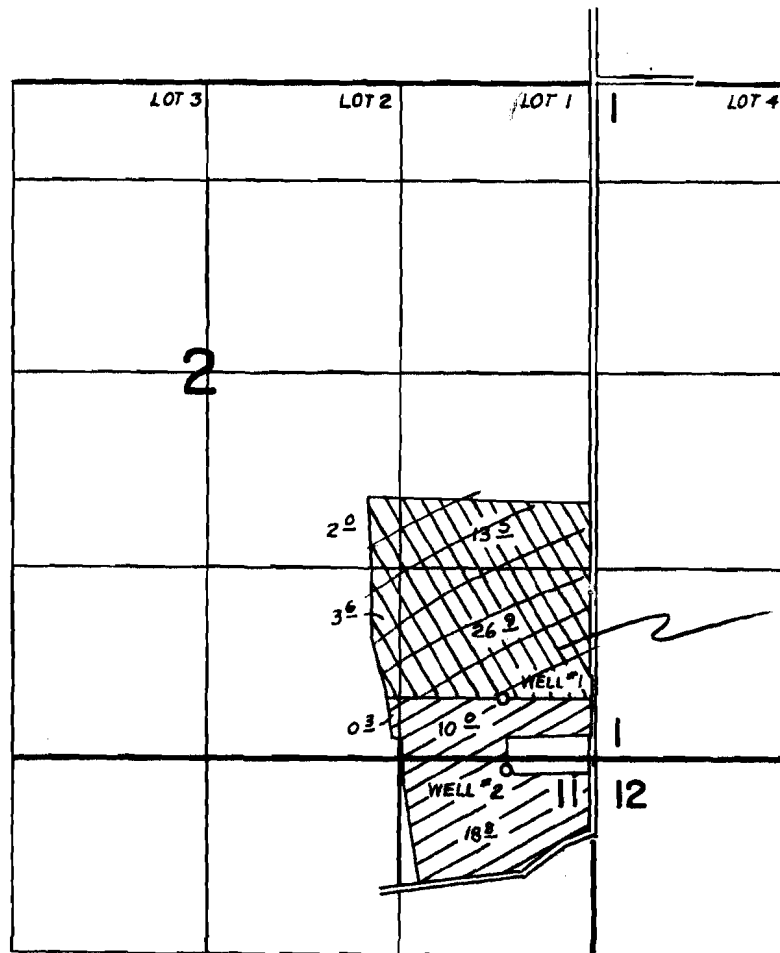

*this portion
cancelled
APR 9, 1976
See out #
43774*

-  WELL #1 4210' S & 600' W FROM NE COR. SEC. 2
 WELL #2 4700' S & 380' W FROM NE COR. SEC. 2

FINAL PROOF SURVEY UNDER

Application No. G-5173 Permit No. G-4904
IN NAME OF

FELIX A. FRAZEE

Surveyed AUG. 22, 1973, by R.G. MUCKEN