


T.15 S.R.4&5 W.W.M.

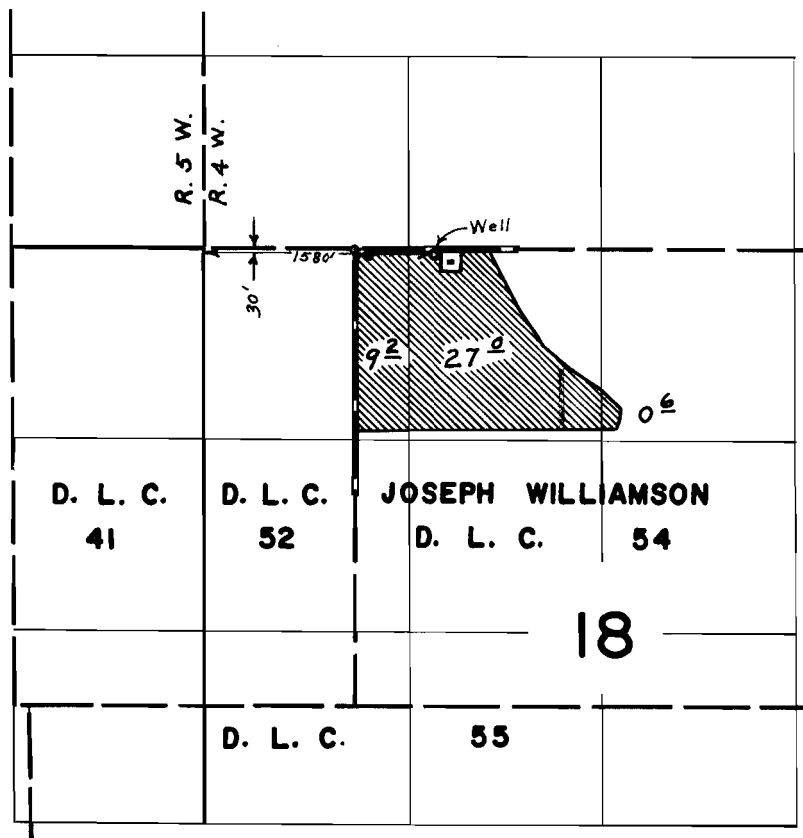

FINAL PROOF SURVEY UNDER

Application No. G-3411 Permit No. G-3199
IN NAME OF
EARL C. & RAYMOND JAGER

Surveyed April 26, 1967, by L. E. Gould