


T.13S.R.1 W.W.M.

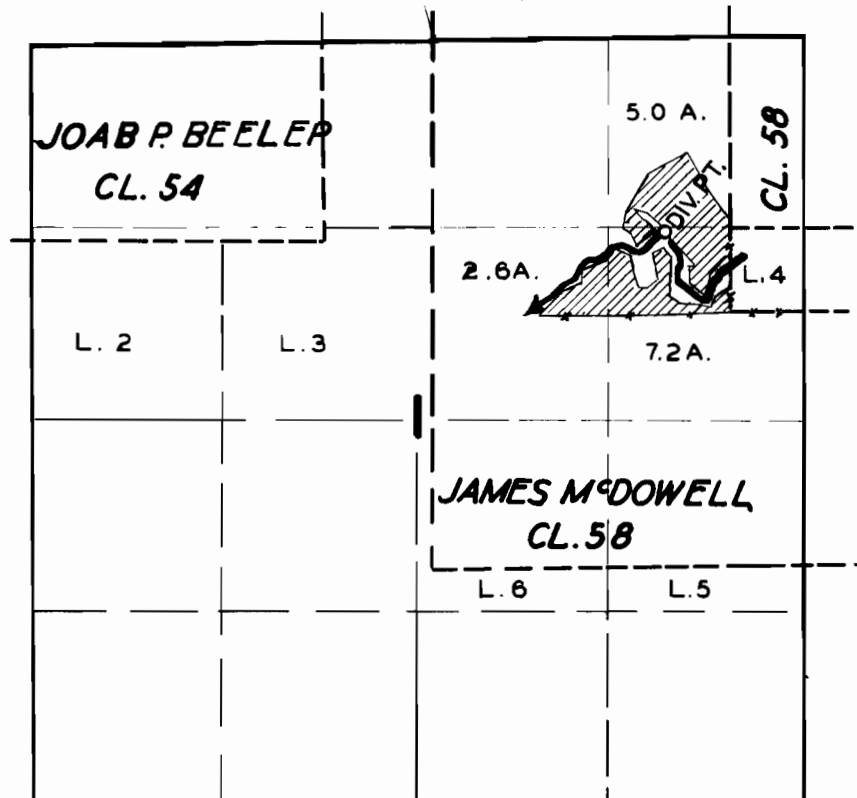

FINAL PROOF SURVEY
UNDER

Application No. 23020 Permit No. 18141
IN NAME OF

CHARLES E. LOTT

Surveyed APR. 18, 1951, by H.L. COFFMAN