


T.12S. R.1W.W.M.

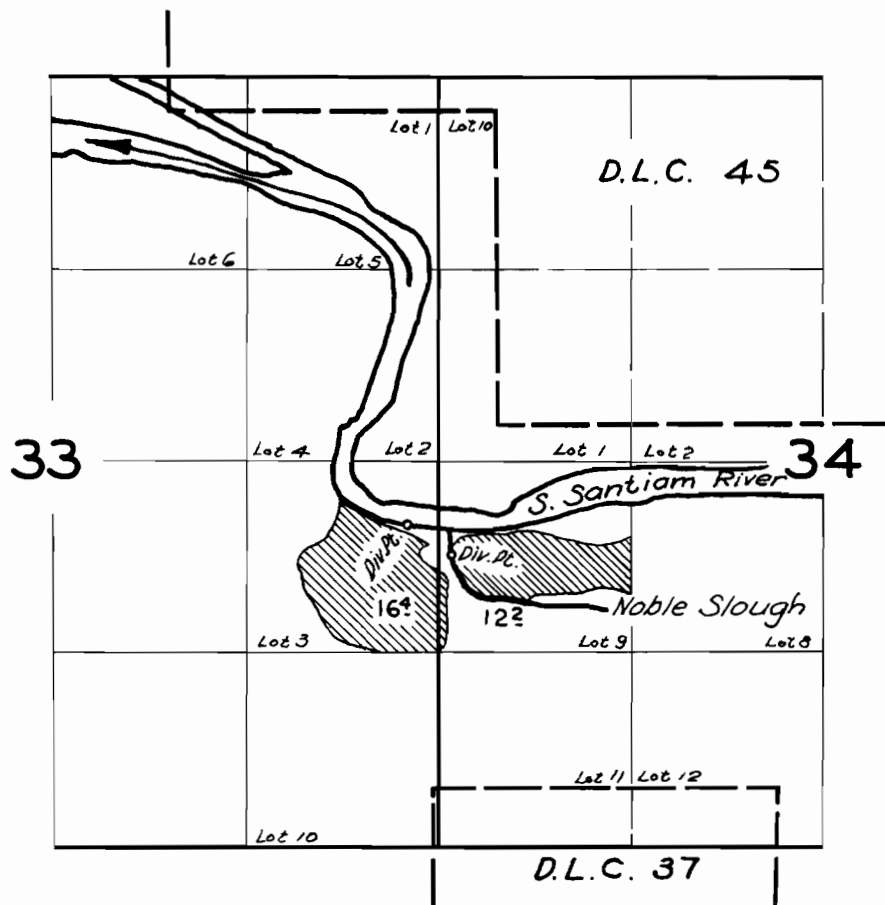

FINAL PROOF SURVEY
UNDER

Application No. 27008. Permit No. 21212..
IN NAME OF

DELILAH B. BROWN

Surveyed 18 July 1958, by C.O. Bartels