


# T.6S. R.1E.W.M.

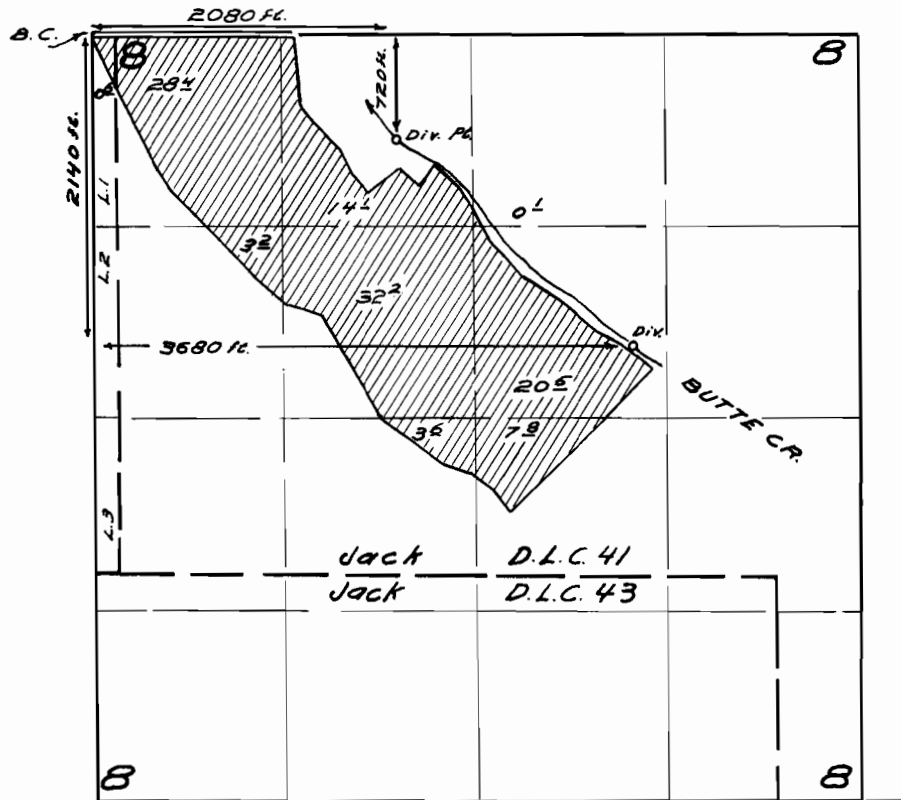

## FINAL PROOF SURVEY UNDER

Application No. 38717 Permit No. 28831  
IN NAME OF

John Clary

Surveyed Sept 27 1966, by W. V. Ruppert