


6-4388

43796  
40922

T.6N. R.36E. W.M.

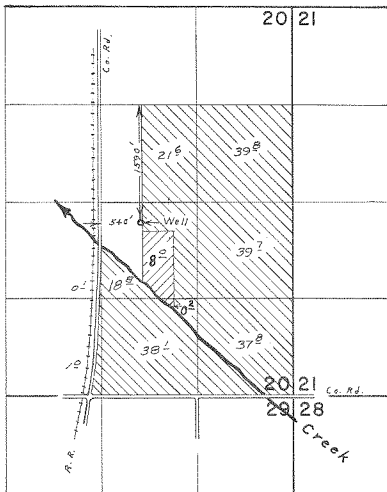

Primary  
Supplemental



FINAL PROOF SURVEY  
UNDER

Application No. G-4664 Permit No. G-4388  
IN NAME OF

DONALD K. SMITH

Surveyed Aug. 9., 1973., by L. E. Gould.