


T.8S.,R.23&24E.,W.M.

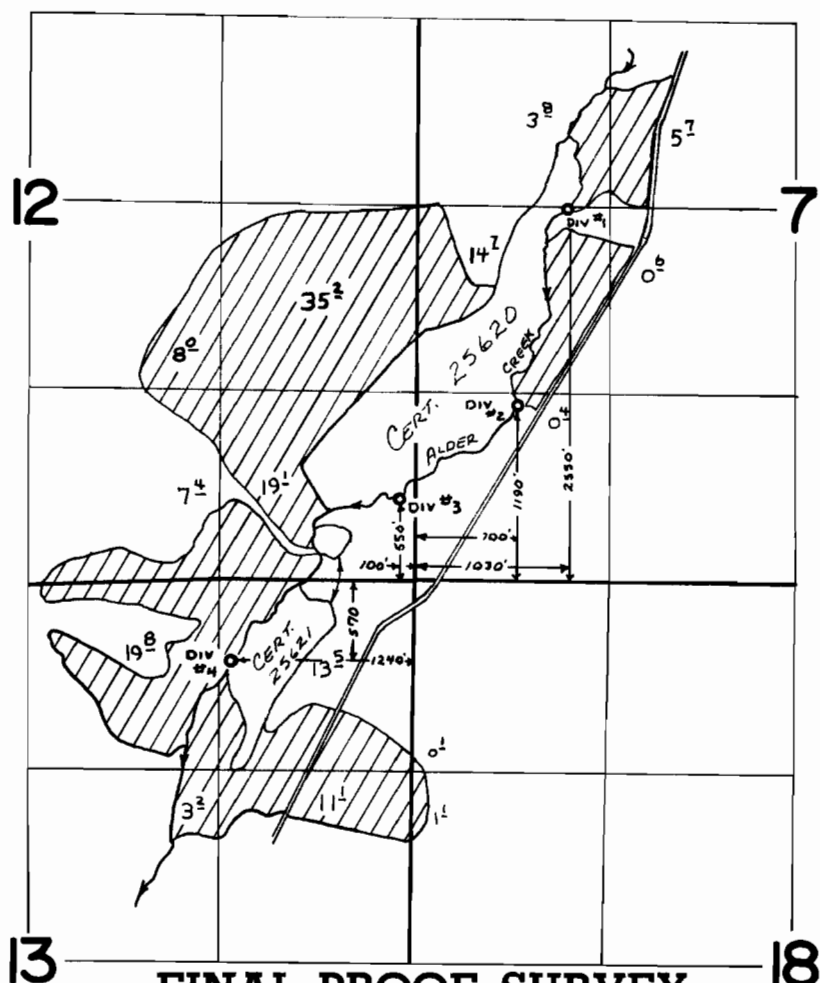

FINAL PROOF SURVEY
UNDER

Transfer No. N-36
N-39

Application No. 43499 Permit No. 32537
IN NAME OF

VICTOR B. NASH

Surveyed Aug. 6, 1974, by L. H. Nunn
JUNE 6 1975 L. Toll