


T.10S. R.40E. W.M.

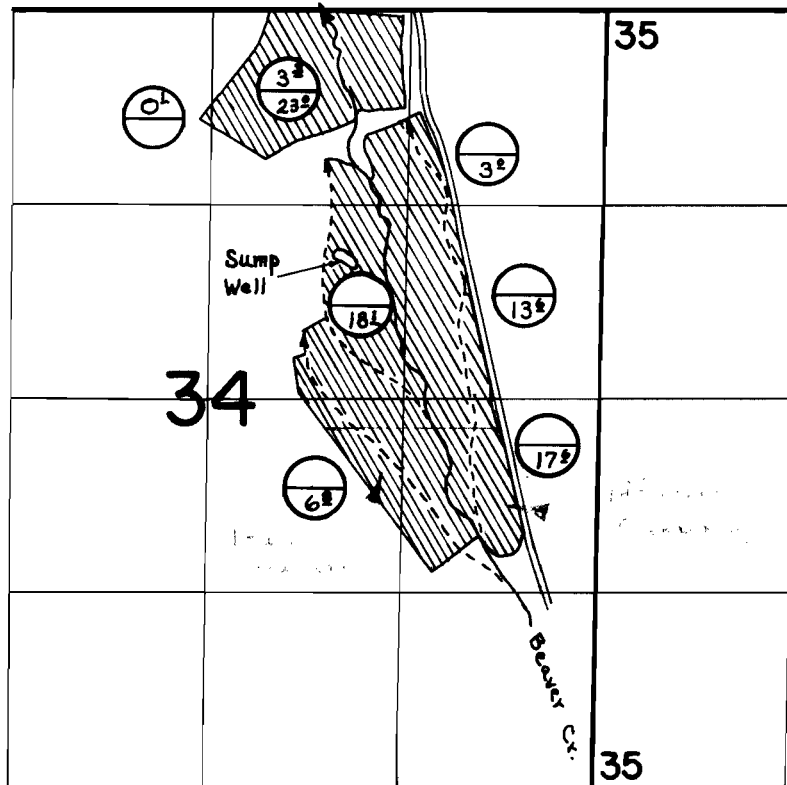

WELL LOCATED: 1710' S. & 1780' W. FROM N.E. CORNER SECTION 34

FINAL PROOF SURVEY
UNDER

Application No. G-3886 Permit No. G-3720
IN NAME OF

EUGENE M. DAVILLA

Surveyed August 25 1975, by R. MUCKEN