


T.13S. R.43E. W.M.

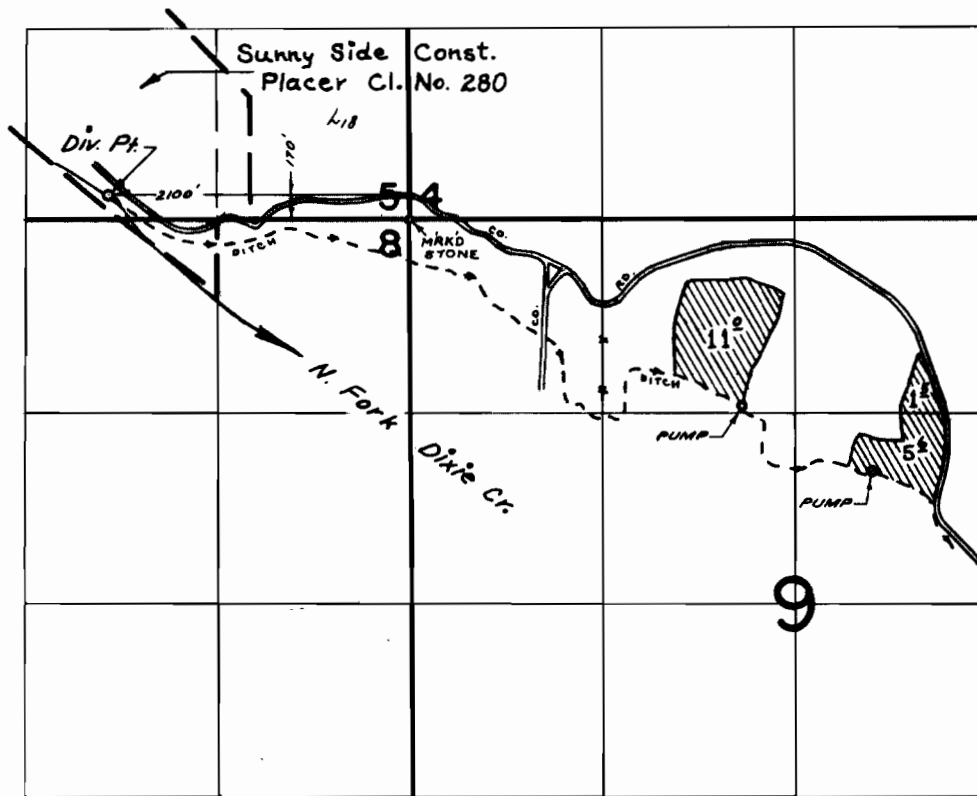

FINAL PROOF SURVEY
UNDER

Application No. 43339 Permit No. 32395
IN NAME OF

HARLAND E. LANGLEY

Surveyed AUG. 21, 1975 by R. MUCKEN