


T.6S. R.43E. W.M.

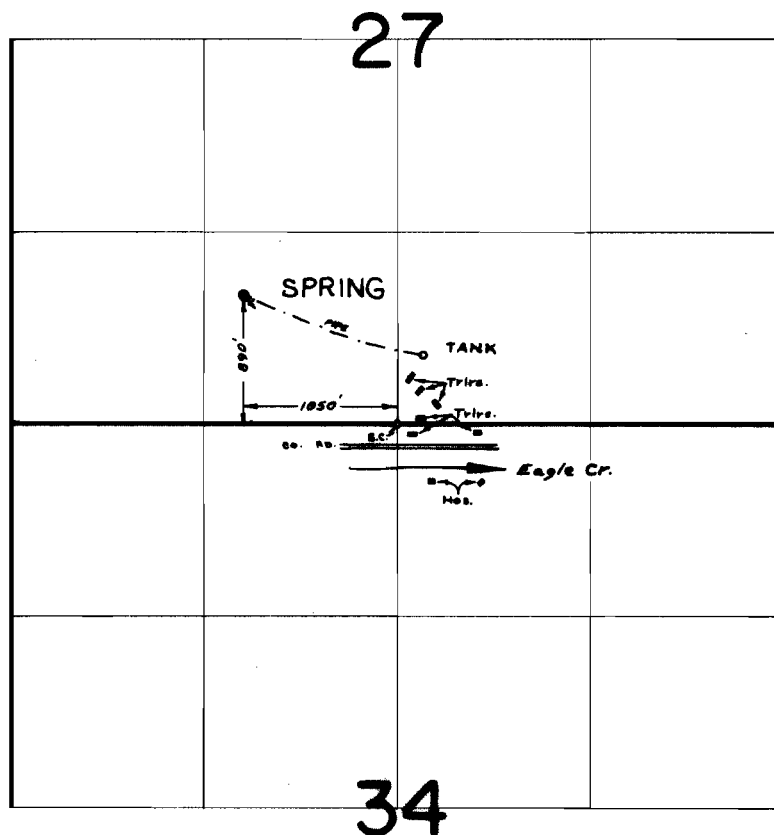

FINAL PROOF SURVEY
UNDER

Application No. 48644 Permit No. 36487
IN NAME OF

WILLIAM B. COLVARD

Surveyed AUG. 28, 1975, by R. MUCKEN