


T.13S. R.44E. W. M.

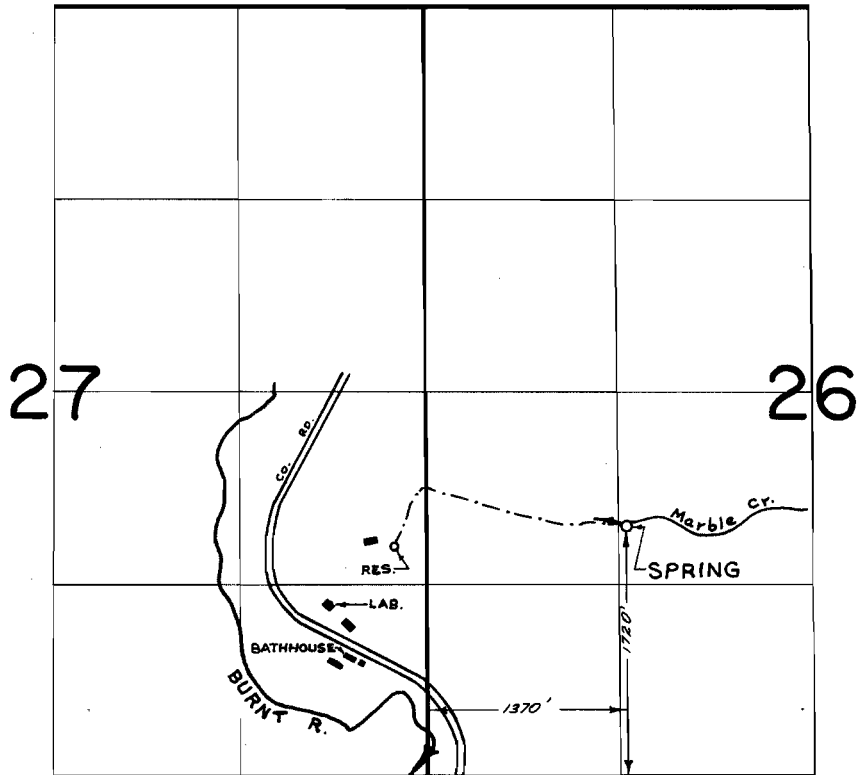

**FINAL PROOF SURVEY**  
UNDER

Application No. 50321 Permit No. 37134  
IN NAME OF

OREGON PORTLAND CEMENT CO.

Surveyed AUG. 21, 1975, by R. MUCKEN