


T.10S., R.6W., W.M.

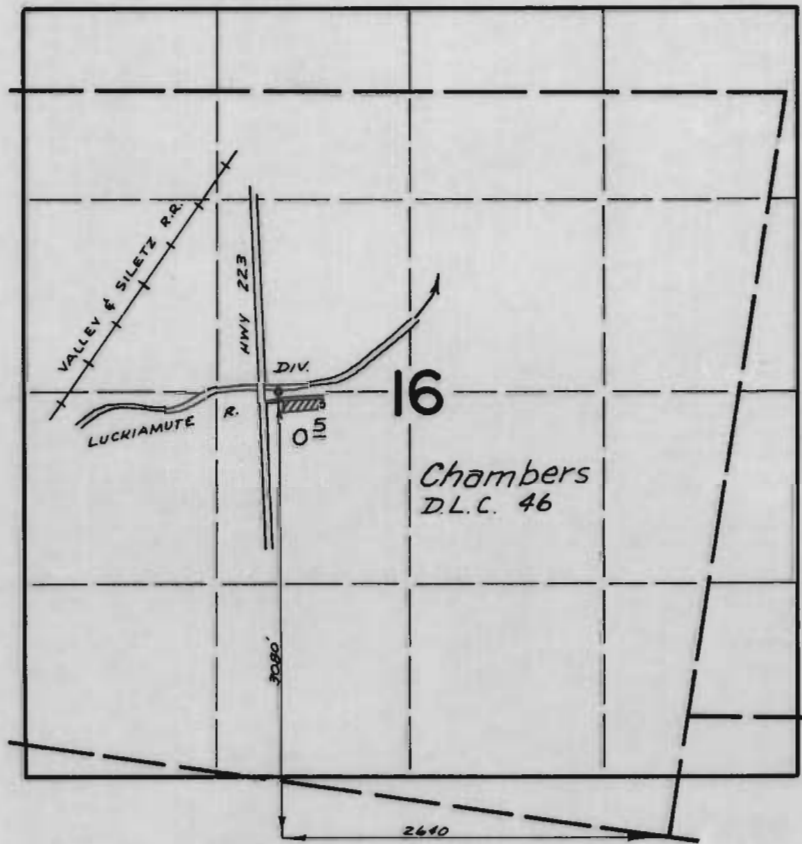

FINAL PROOF SURVEY
UNDER

Application No. 47853 Permit No. 35863
IN NAME OF

DAVID BRUCE ROWE

Surveyed Aug 22 1973, by D. Norby