


T.6S. R.1E. W.M.

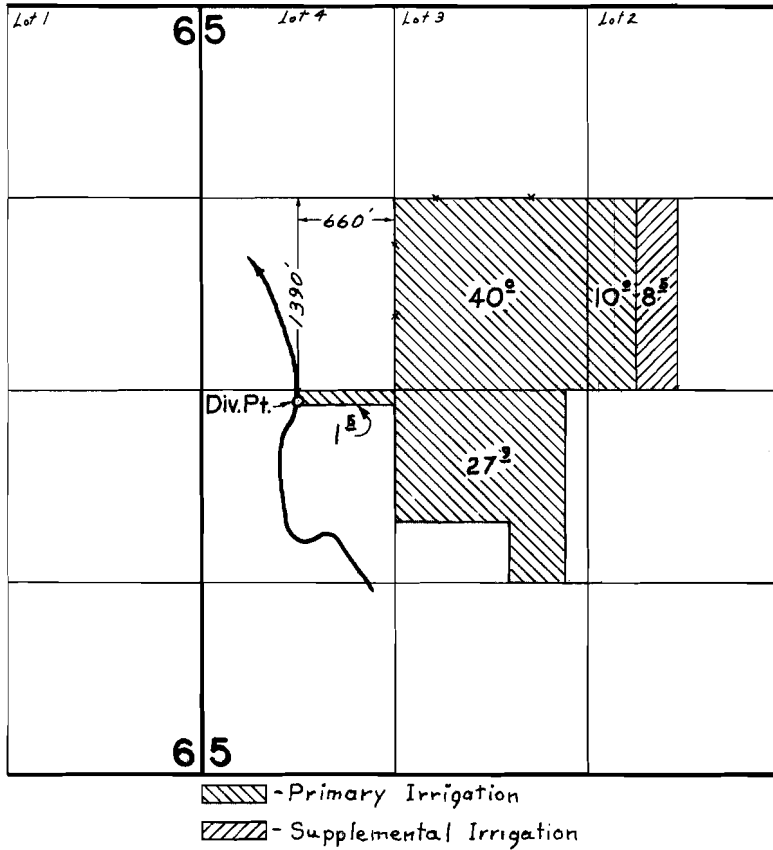

FINAL PROOF SURVEY UNDER

Application No. 39986 Permit No. 29785
IN NAME OF

WARREN & HELEN BREMER

Surveyed JULY 19, 1974, by L.E. GOULD