


T.2S.R.4E.W.M.

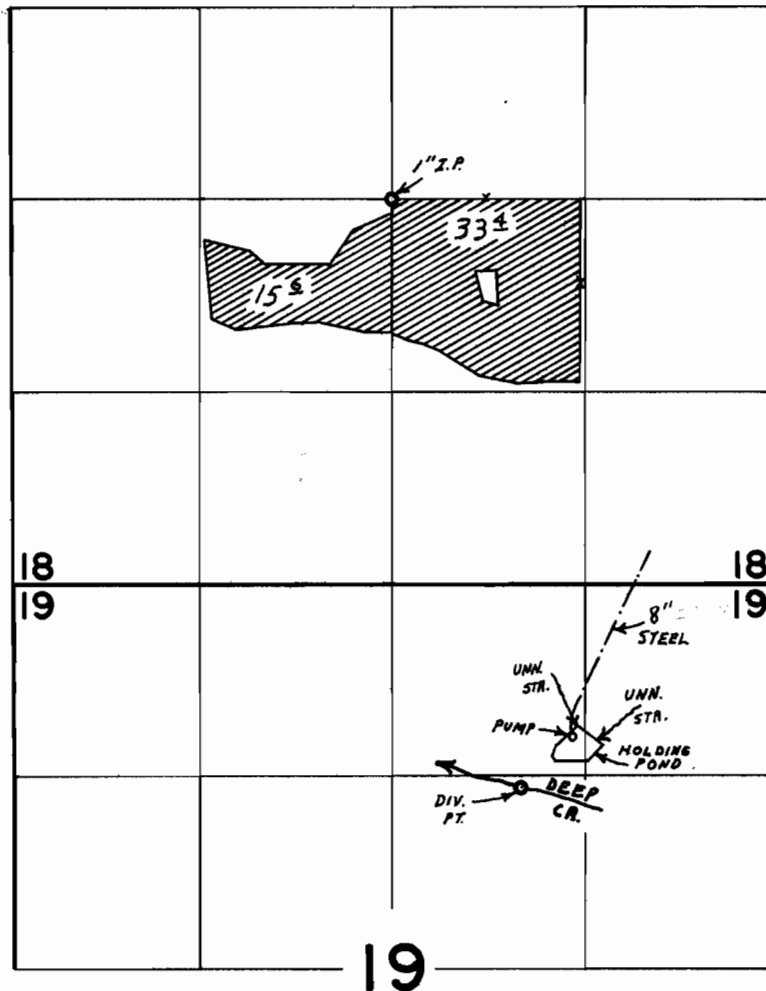

DIV. PT. LOC. 4090'S. & 890'E. FROM CENTER SEC. 18

FINAL PROOF SURVEY
UNDER

Application No. 41785 Permit No. 31187

IN NAME OF

R.E. and L.V. SCHEDEEN

Surveyed NOV. 9 1970, by G. BACA