T. 3 S. R. 1 W. W.M.

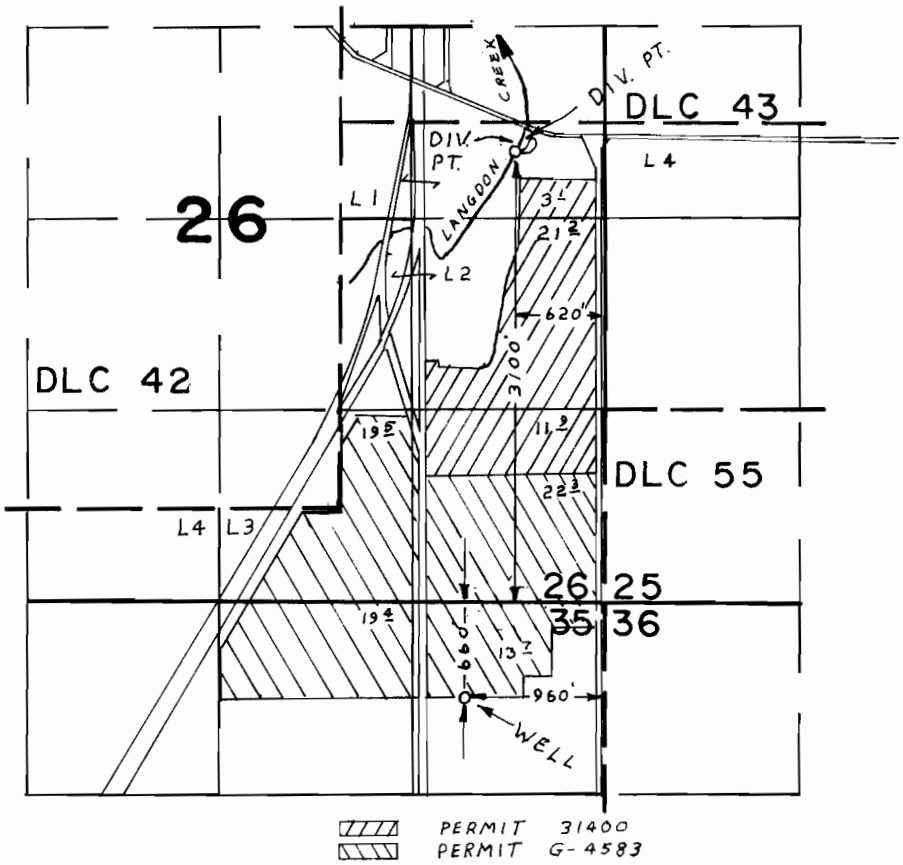

FINAL PROOF SURVEY
UNDER

Application No. G-4868 (42874) Permit No. G-4583 (31400)
IN NAME OF

HAROLD A. AND EMMA I. LANGDON

Surveyed AUG 13 1974, by LH NUNN

DFK- 2LL-3 LHN