


T.3 S. R.1 E. W.M.

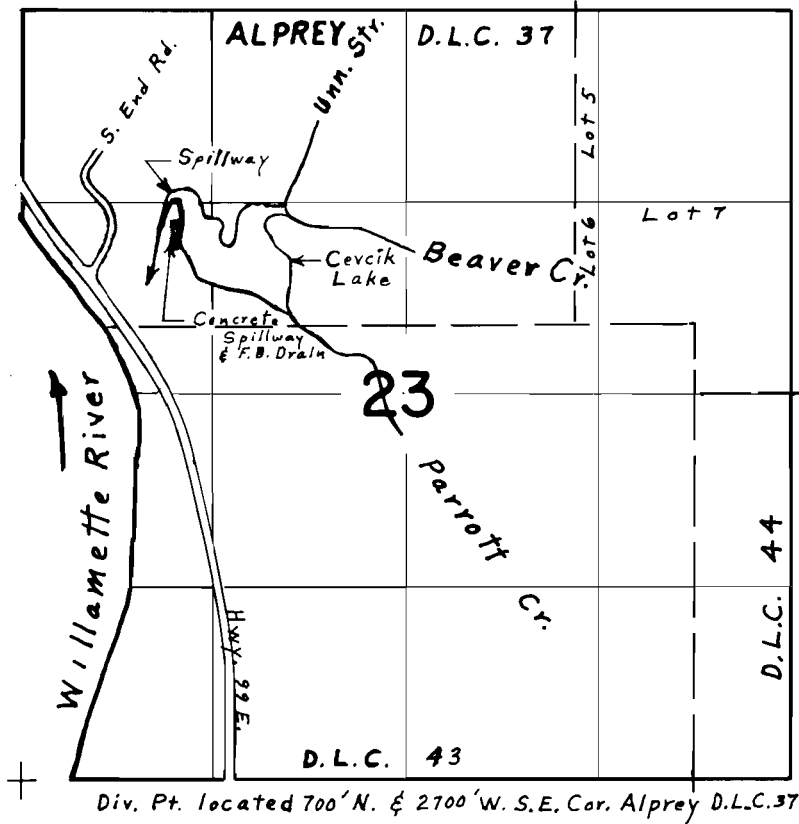

FINAL PROOF SURVEY UNDER

R-46544 R-5524
 Application No. ~~46545~~ Permit No. ~~34653~~
 IN NAME OF

LAKE ERA CORPORATION

Surveyed Oct. 1, 1975, by L. E. Gould