


T.6N.,R.7W.,W.M.

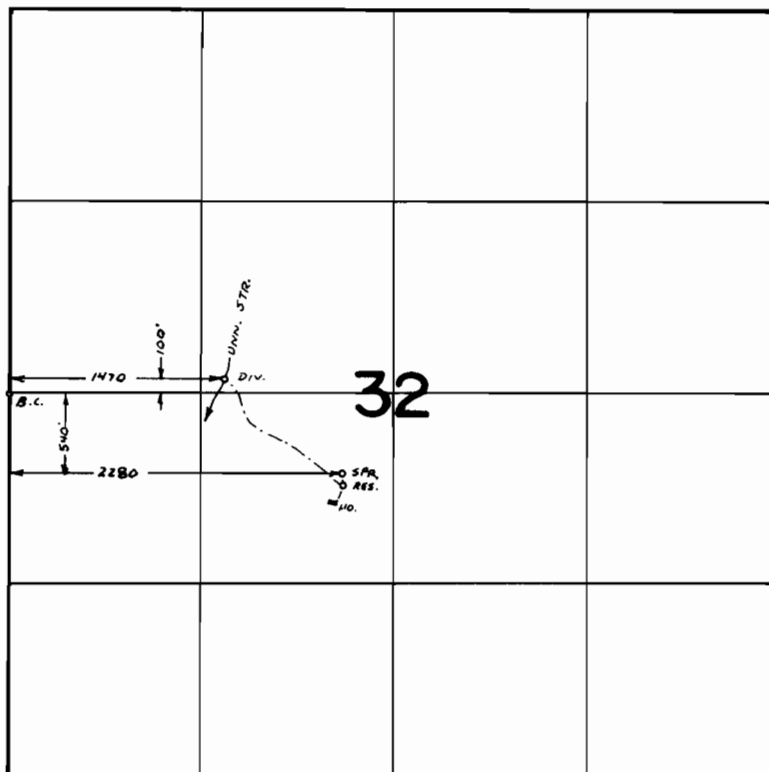

FINAL PROOF SURVEY
UNDER

Application No. 47097 Permit No. 35238
IN NAME OF

HOWARD L. & DONNA M. BUTLER

Surveyed SEPT. 24 1975, by L. E. Gault