


T.25S., R.12W., W.M.

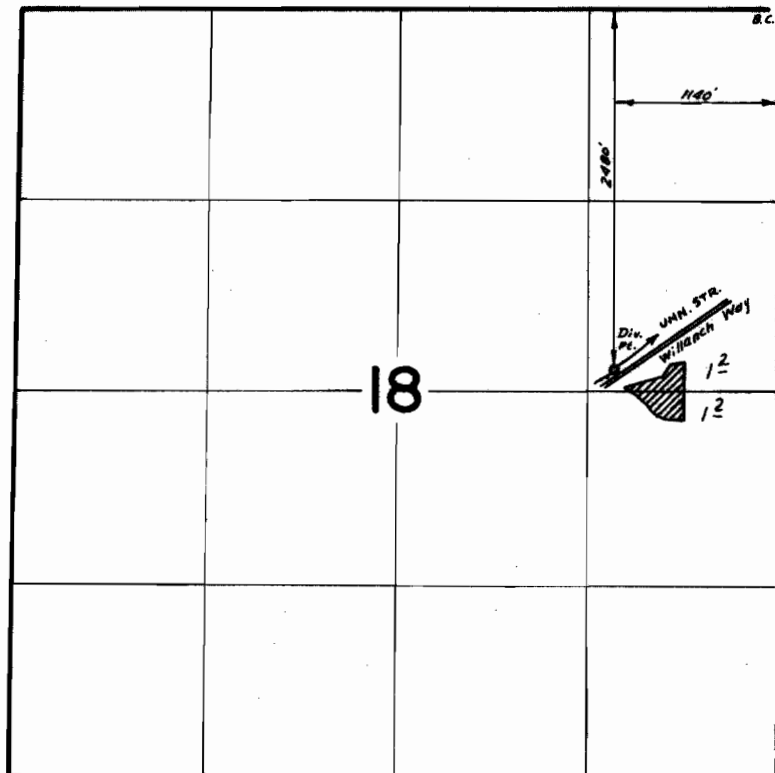

FINAL PROOF SURVEY
UNDER

Application No. 48007 Permit No. 36005
IN NAME OF

JAMES MICHAEL SHUMAKE

Surveyed Sept. 19 1975, by D. Norby