


T.41S.,R.13W.,W.M.

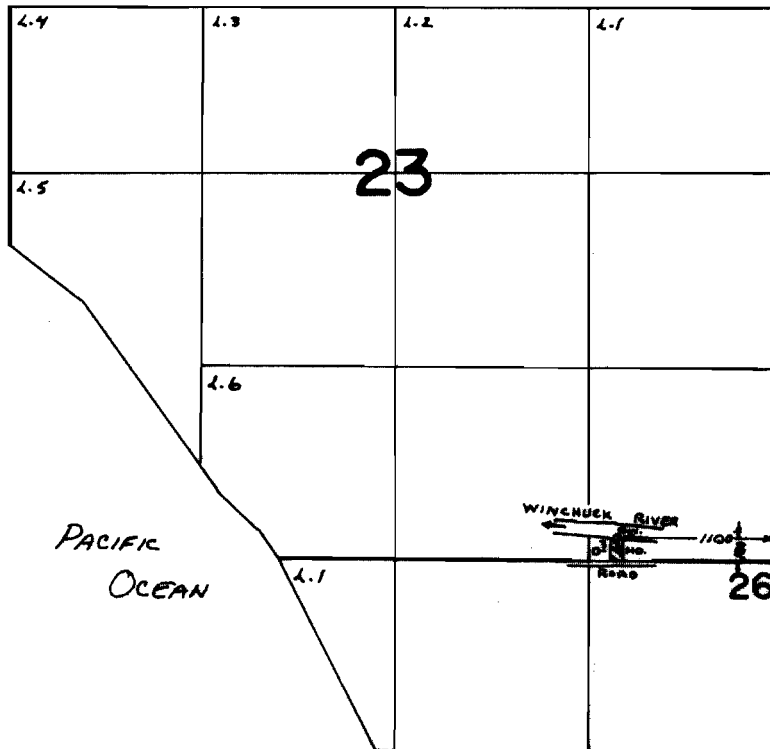

FINAL PROOF SURVEY
UNDER

Application No. 51928 Permit No. 37742
IN NAME OF

CLARK C. AKIN

Surveyed JUN 19 1975 by L. Toll