


T.14S., R.13E., W.M.

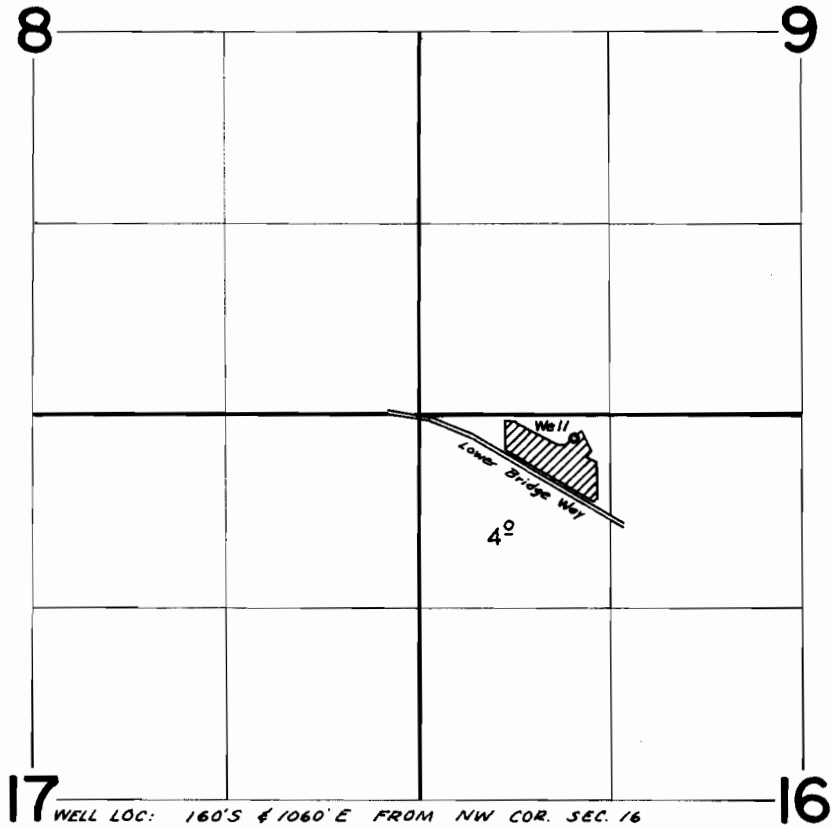

FINAL PROOF SURVEY
UNDER

Application No. G-4721 Permit No. G-4444
IN NAME OF

DALE AND/OR SHIRLEY CRAWFORD

Surveyed Oct. 28 1975, by D. Norby