


T.15S., R.11E., W.M.

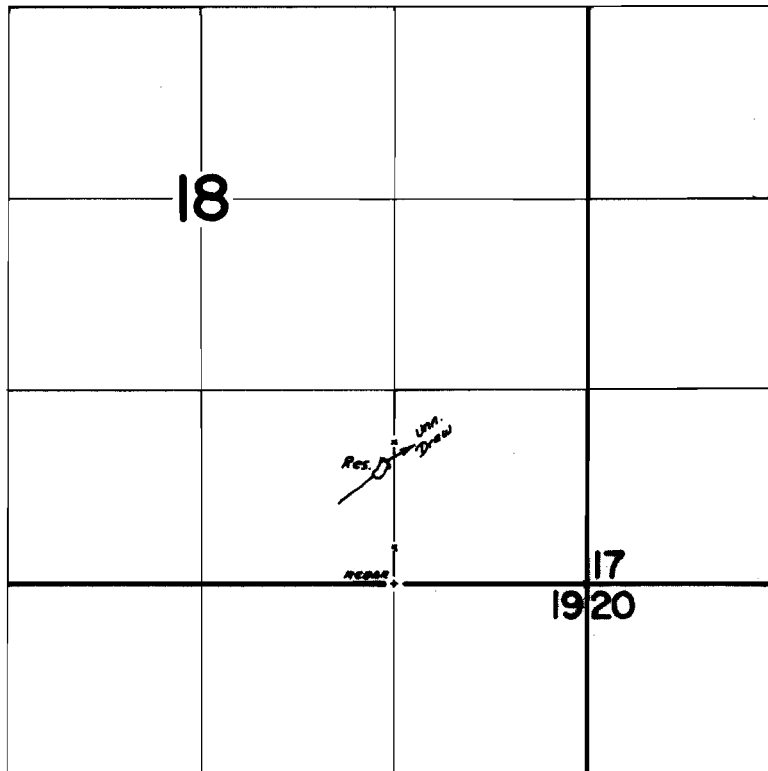

RES. LOC: 850' N & 50' W FROM SE COR. SW $\frac{1}{4}$ SE $\frac{1}{4}$ SEC. 18.

FINAL PROOF SURVEY
UNDER

R-49106 R-5978
Application No. 49350..... Permit No. 36938.....
IN NAME OF

GRACE H. VERMILYEA

Surveyed Oct. 28 1975, by D. Norby