T.22S., R.9W., W.M.

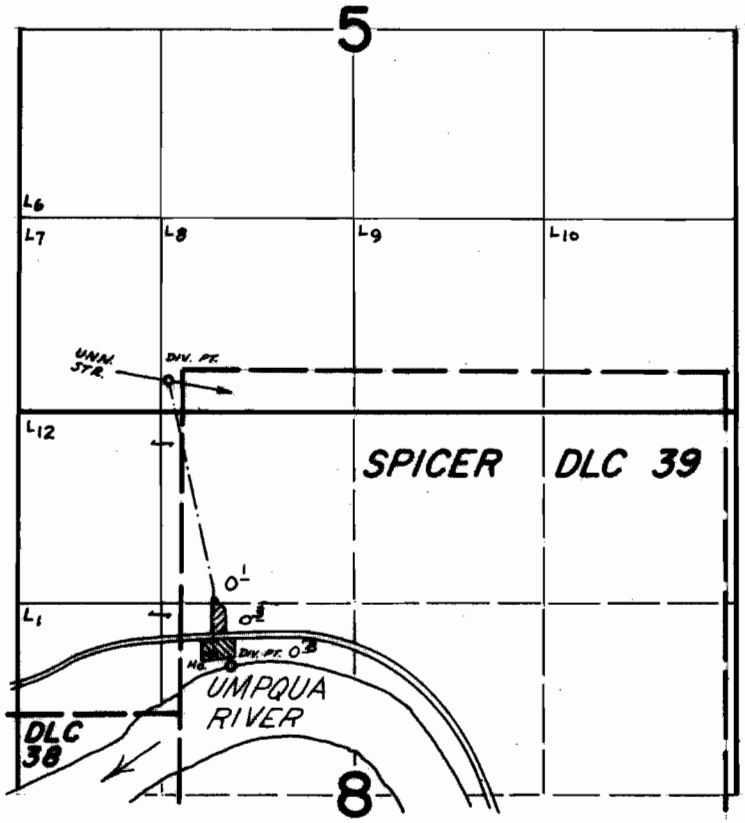

DIV. PTS. LOC: STR- 1530' N & 100' W; RIV.- 430' S & 480' E FROM SE COR. LOT 12 SEC. 8

UNN. STR.

UMPQUA RIVER

FINAL PROOF SURVEY
UNDER

Application No. 45701 Permit No. 34093
IN NAME OF

ESTATE OF ROY H. LEWIS

Surveyed July 24 1975, by D. Norby

BTR-6HH-11