


T.28S., R.4W., W.M.

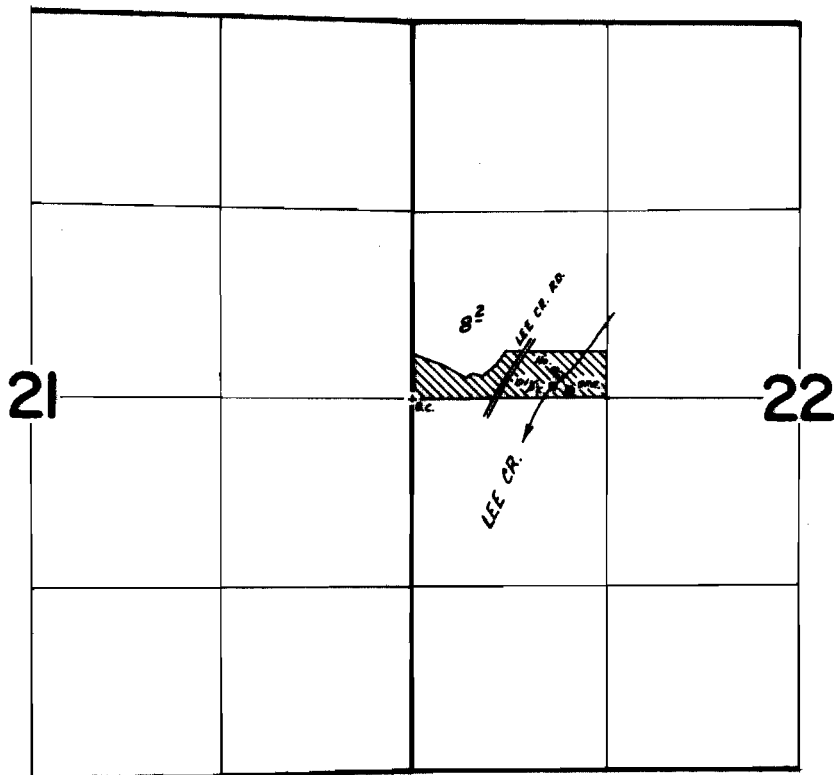

DIV. PTS. LOC: SPRING - 50' N & 1070' E; CREEK - 80' N & 960' E, BOTH FROM
W 1/4 COR. SEC. 22.

FINAL PROOF SURVEY
UNDER

Application No. 46368..... Permit No. 34635.....
IN NAME OF

HERMAN C. AND HAZEL L. OSBORNE

Surveyed Nov. 7..... 1975, by D. Norby.....