


T.27S. R.3W. W.M.

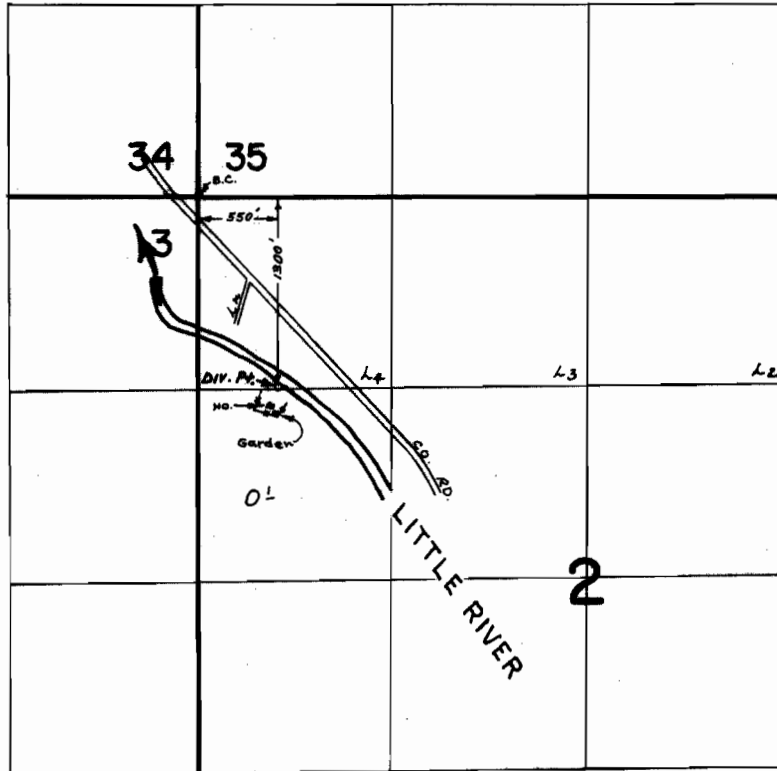

**FINAL PROOF SURVEY**  
UNDER

Application No. 46946 Permit No. 35109  
IN NAME OF

STEVE SAND

Surveyed SEPT 18, 1975, by R. MUCKEN