


T.26S. R.2W. W.M.

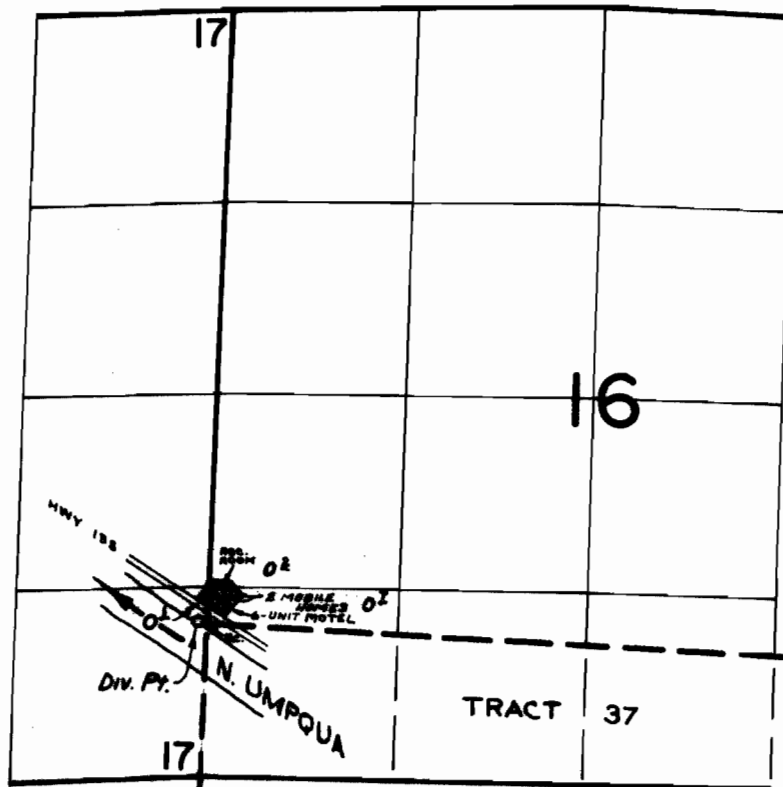

DIV. PT. LOC. 10' N. AND 60' W. FROM N. W. CORNER TRACT 37

**FINAL PROOF SURVEY**  
UNDER

Application No. 48670 Permit No. 35924  
IN NAME OF

HARRY & ARDETH COLLINS

Surveyed SEPT. 17, 1975, by R. MUCKEN