


T.29S. R.8W. W.M.

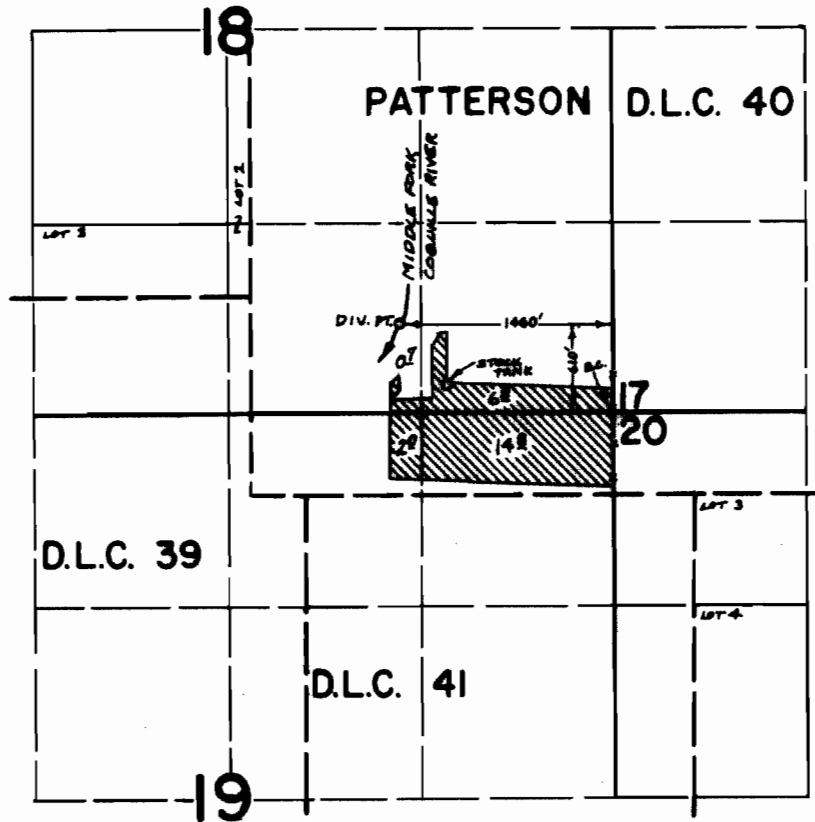

**FINAL PROOF SURVEY**  
UNDER

Application No. 49335 Permit No. 36985  
IN NAME OF

NOBLE STANDLEY

Surveyed MARCH 26 1975, by L. TOLL