


C-42024  
P-36298  
C-43836

# T.14S. R.31E. W.M.

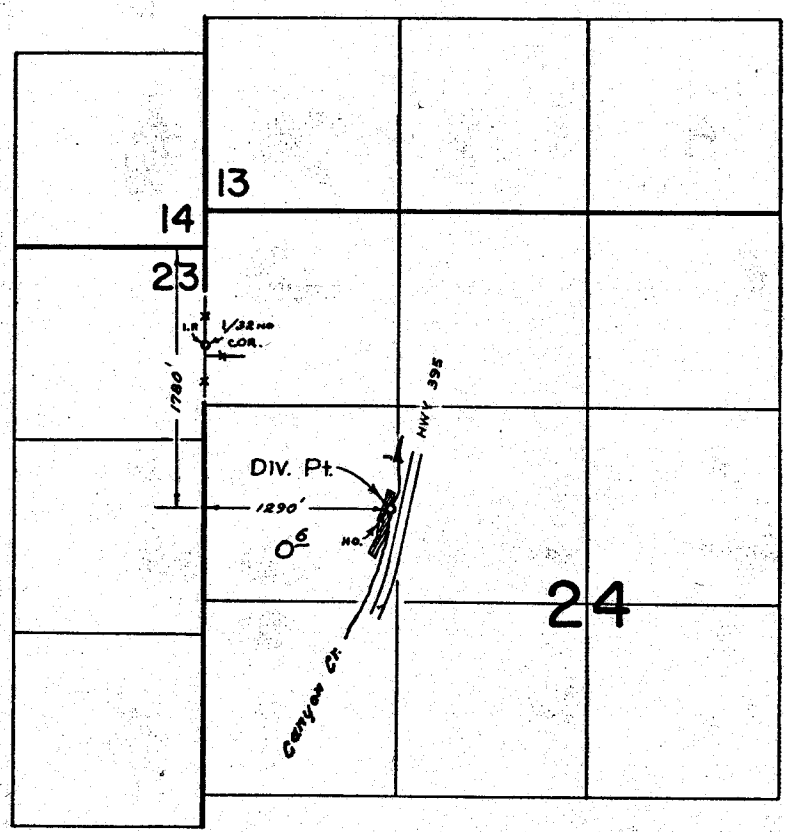

## FINAL PROOF SURVEY UNDER

Application No. 48340 Permit No. 36298  
IN NAME OF  
G. B. FROST

Surveyed JUNE 23, 1975, by R. MUCKEN