


T.35S., R.2W., W.M.

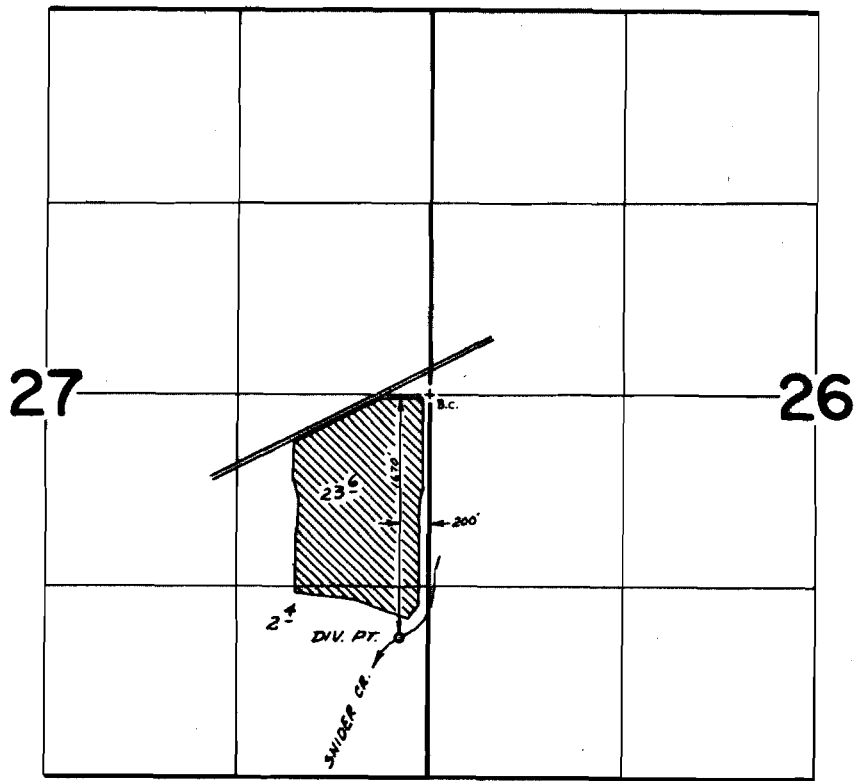

FINAL PROOF SURVEY UNDER

Application No. 42170 Permit No. 31558
IN NAME OF

WERNER J. DONAT

Surveyed May 1 1975, by D. Norby