


T. 35 S. R. 4 W. W.M.

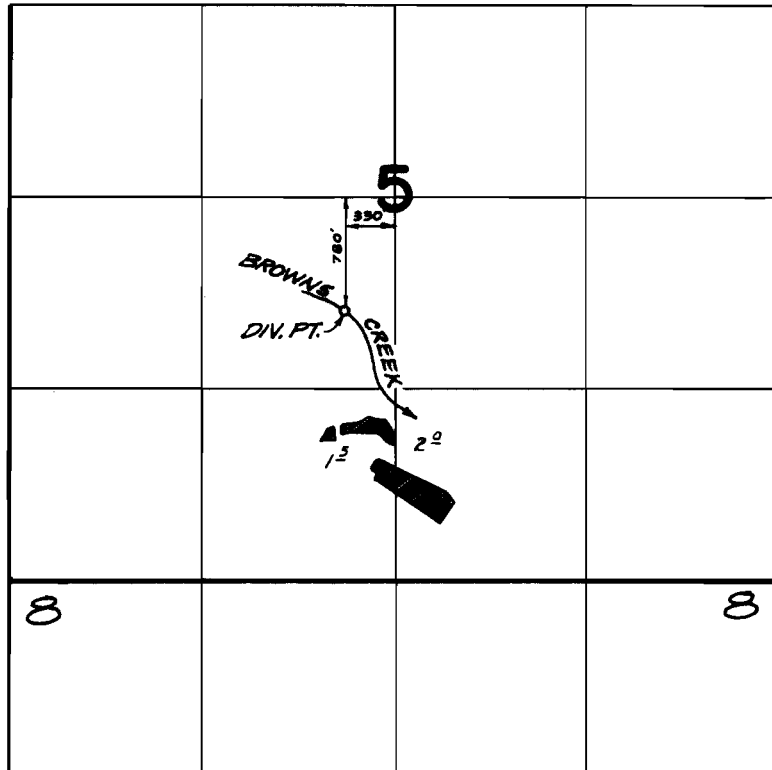

FINAL PROOF SURVEY UNDER

Application No. 44023 Permit No. 32905
IN NAME OF

ROBERT L. STEVENSON

Surveyed JULY 25 1974, by D. NORBY