


T. 34 S. R. 2 W. W.M.

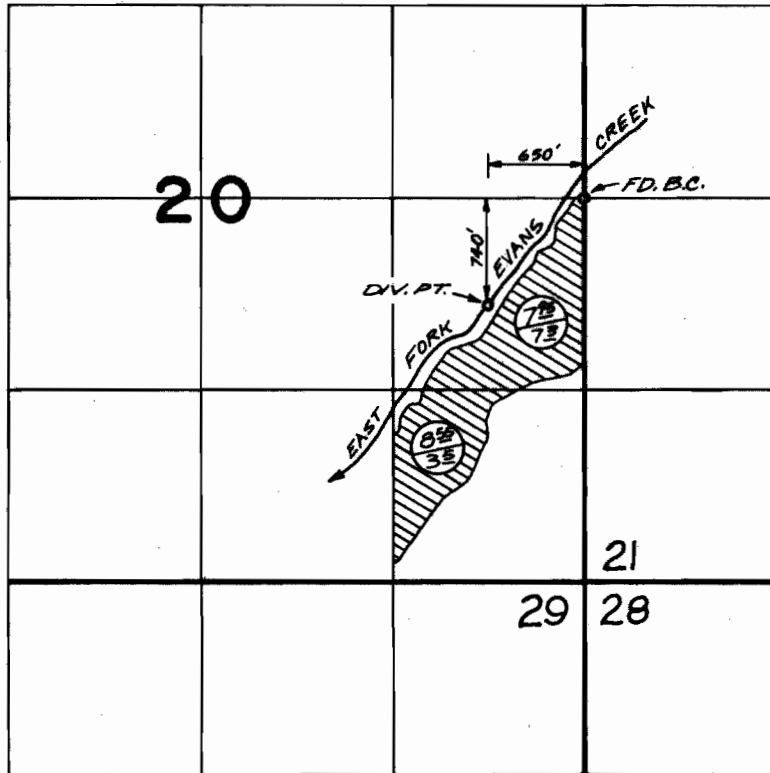

CERTIFICATE 22331
PERMIT 35136

FINAL PROOF SURVEY
UNDER

Application No. 46956 Permit No. 35136
IN NAME OF

GERALDINE S. BRYANT

Surveyed JULY 30 1974, by D. NORBY