


T.40S.R.1E.W.M.

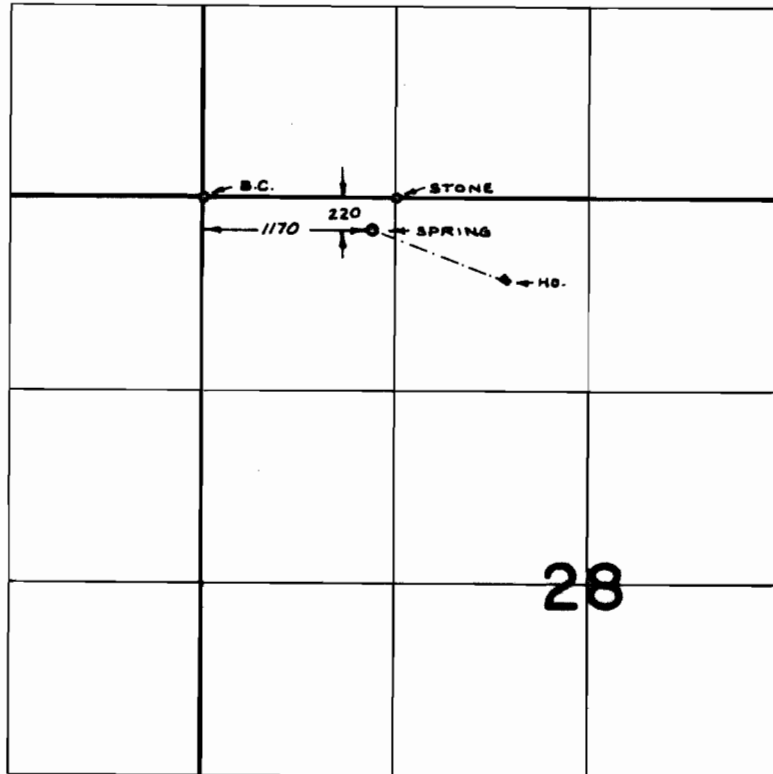

**FINAL PROOF SURVEY**  
UNDER

Application No. 42070 Permit No. 36816  
IN NAME OF

LELAND R. DRESSLER

Surveyed SEPT. 23, 1974, by R. MUCKEN