


T.36S. R.6W. W.M.

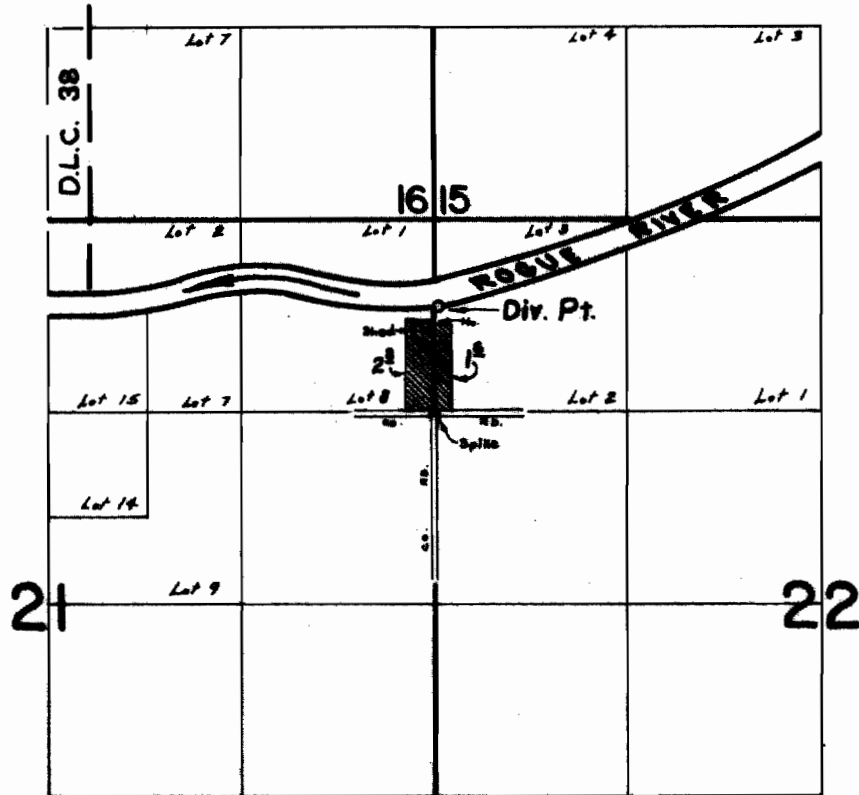

Div. Pt. Loc: 730' N.  $\frac{1}{4}$  30' E. From S.W. cor. Lot 2 N.W.  $\frac{1}{4}$  N.W.  $\frac{1}{4}$  Section 22

**FINAL PROOF SURVEY**  
UNDER

Application No. 45762 Permit No. 34159  
IN NAME OF

L.A.  $\frac{1}{2}$  PATRICIA J. MOORE

Surveyed MAY 20, 1974, by L.E. GOULD