


T.20S. R.3W. W.M.

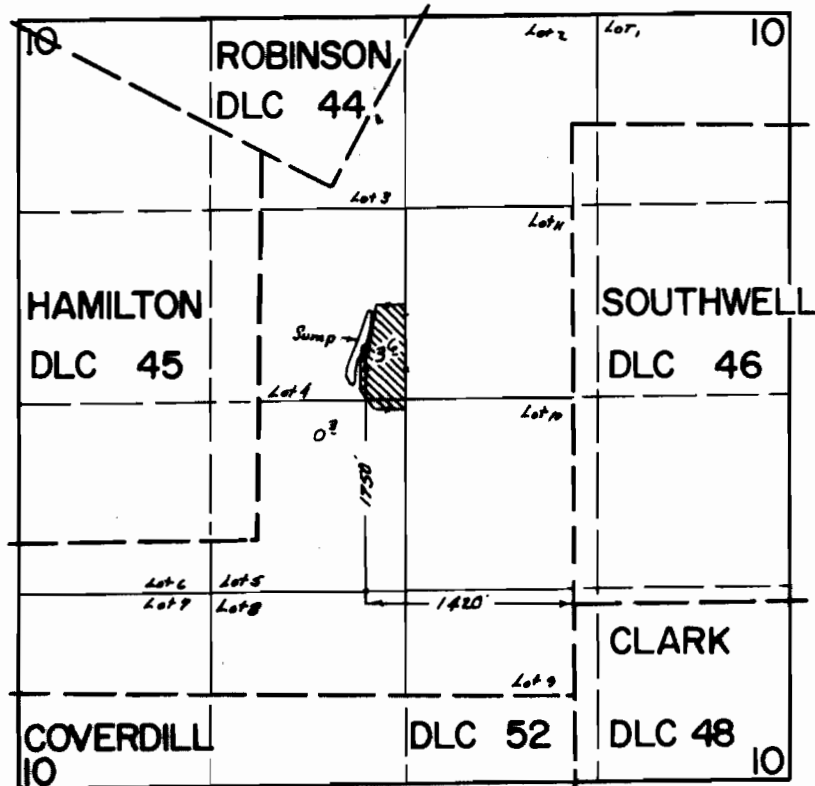

FINAL PROOF SURVEY
UNDER

Application No. G-4960 Permit No. G-4680.
IN NAME OF

JAMES H. WILLIAMS

Surveyed Aug. 13. 1974, by D. M. NORBY.