


T.16S. R.2E. W. M.

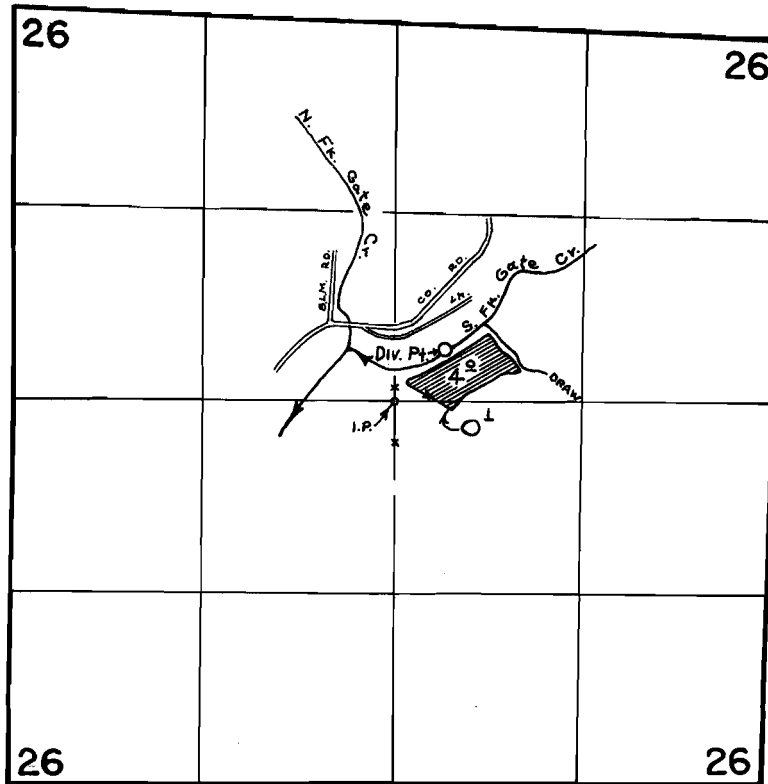

DIV. PT. LOC: 350' N. & 340' E. FROM CEN. SEC. 26

FINAL PROOF SURVEY
UNDER

Application No. 43672 Permit No. 32646
IN NAME OF

GERALD R. & JOAN E. PATTERSON

Surveyed APRIL 24, 1975, by R. MUCKEN