


T.19S. R.12W. W.M..

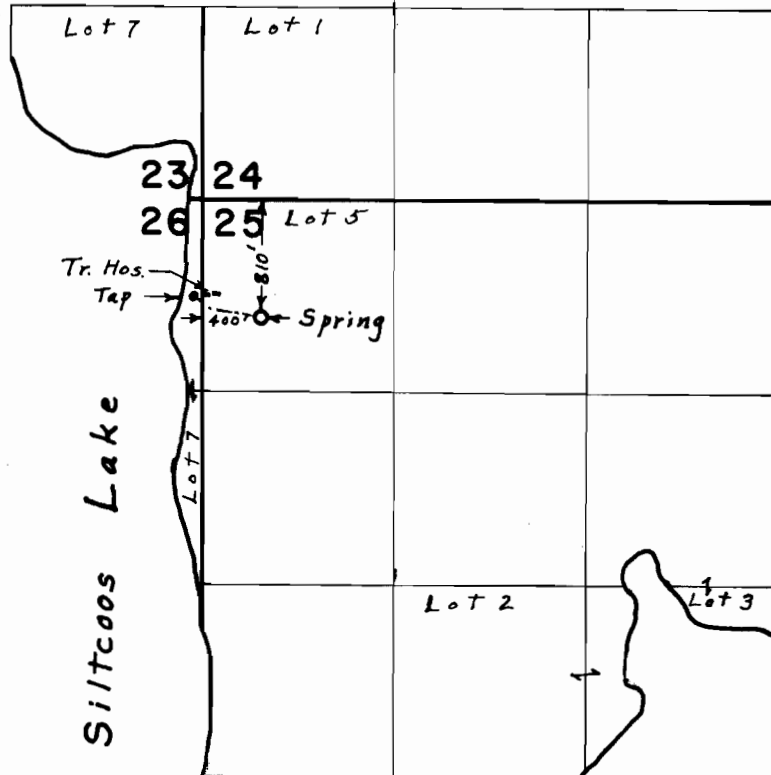

FINAL PROOF SURVEY
UNDER

Application No. 45054 Permit No. 33669
IN NAME OF

CLIFTON S. SAUBERT

Surveyed July 12 1974, by L. E. Gould