


T.16S. R.7W. W. M.

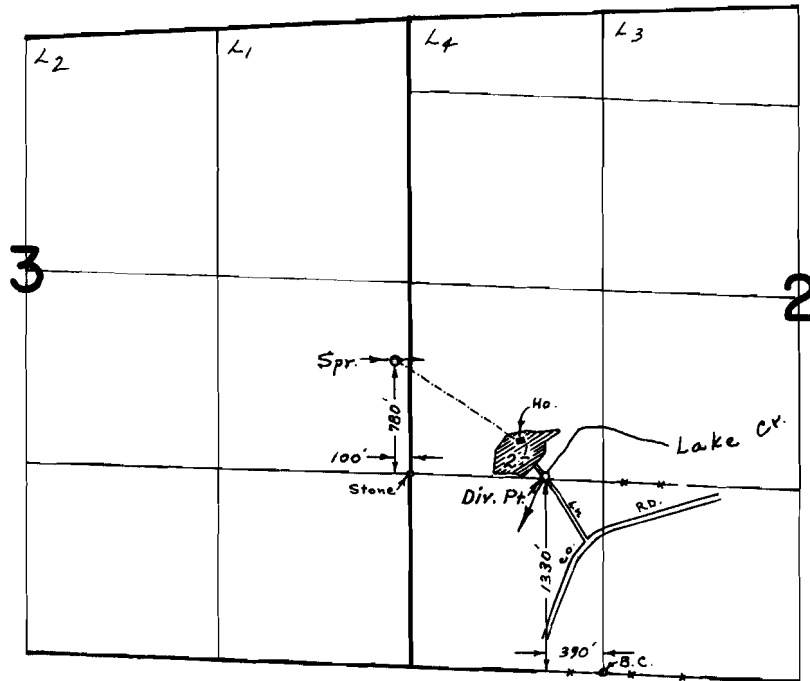

FINAL PROOF SURVEY
UNDER

Application No. 45481 Permit No. 33940
IN NAME OF

MARVIN NEWPORT

Surveyed May 6, 1975, by R. Mucken